

Name Andrew W. Rennie

Service No. 126 - 1950

Address 10 Farmcrest Avenue

Location 10 Farmcrest Avenue

Kind of Pipe

Size

Size of Main

~~Repair~~ ~~Renovate~~ ~~Excavate~~ New Service

*Com. 5/28/51*

Location

Date	Material	Amount	Total	Date	Amount
2/26/51	Labor		21 03	11/21/50	125 00
	10% Overhead		2 01	4-2-51	(27) 49
	42'-6" Sewer Pipe @ .344		14 45		97 51
	Joint Compound		2 52		
	8 Hrs. Littlefield Shovel		56 00		
	2 Hrs. Trucking		1 50		
			97 51		
	Labor				

TOWN OF LEXINGTON—DEPT. OF PUBLIC WORKS  
**SEWER DIVISION**

DATE .....

NO. ....


The undersigned applies for the construction of a particular sewer connecting No. ....  
 Street and hereby agrees to comply with the Rules and Regulations governing the construction **and** use of Particular  
 Sewers, as now or at any future time established by the Board of Selectmen.

Am't of estimate \$.....

Am't Paid \$.....

..... Owner

**Sketch of Service Here**

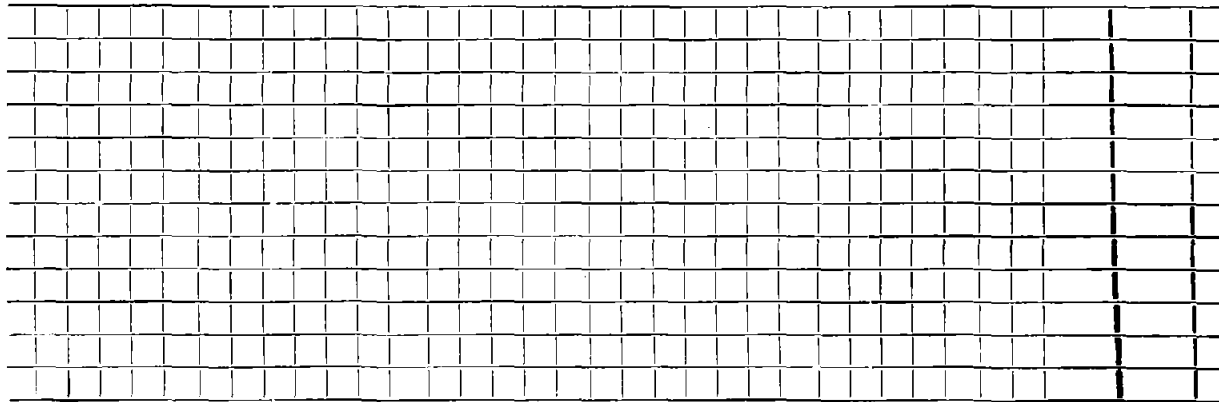

Connection made in ..... Street.

Work completed .. - - - - - 19..

Remarks: