

Name Donna Realty Trust

Service No. 110

Address 19 Farmcrest Avenue

Location

Kind of Pipe

Size

Size of Main

Repair—Renewal—New Service W.O.#5426 Valeri #763

Location AUG 5 1968

Date		Material	Amount	Total	Date		Amount
9-22-67	32'	6" Transite pipe			9-8-67	Deposit	100 00
	10'	4" Cast Iron pipe			8-5-68	Paid by W.O.#63	35 45
9-21-67		Labor 82.74			11-29-68	PAID	52 82
9-26-67		" 20.45	103.19				188 24
		10% O.H.	10.32	113.51			
	30'	6" Transite pipe @88		26.40			
	1/2	bag cement @1.55		.78			
	2	ton Cold Patch @5.50		11.00			
	1	ton Hot top		5.80			
	3	hrs. Trucking @3.00		9.00			
	2 1/2	hrs. Shovel @6.50		16.25			
	1/2	hr. Loader @4.00		2.00	1-4-71	Plugged Sewer - Roots	
	1/2	hr. Roler & Trailer		3.50			
				188.24			


DATE _____

TOWN OF LEXINGTON — BOARD OF PUBLIC WORKS

SEWER DIVISION

Sketch of Service Here

19

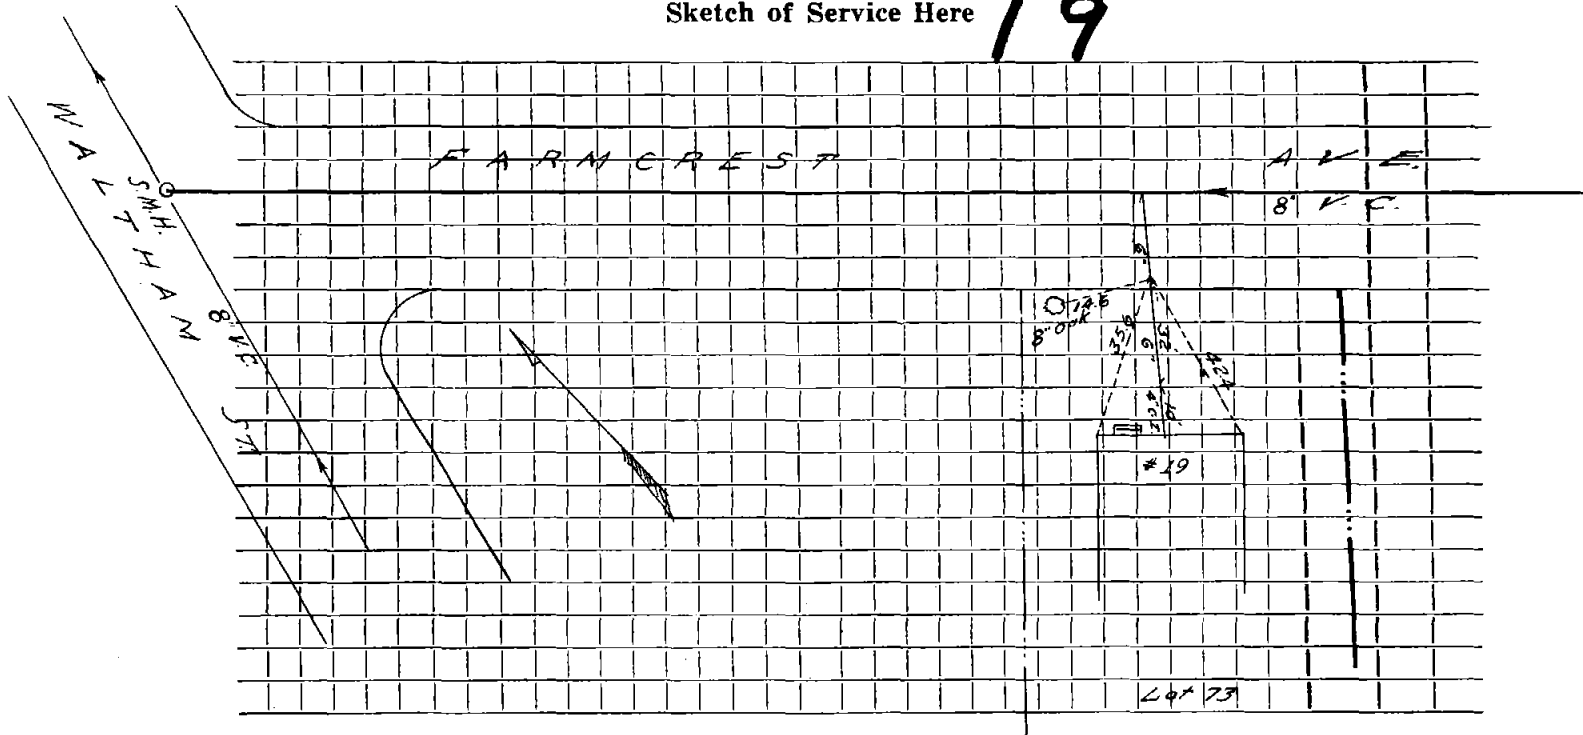

Connection made in Street. Work completed

Remarks:
.....
.....