

Name **Arthur Morse**

Service No. 85

Address **23 Farmcrest Avenue**

Lexington

Location **23 Farmcrest Avenue**

Kind of Pipe

Size

Size of Main

Repair ~~Renewal~~ **New Service**

Conn. 11-6-50

Location

Date		Material	Amount	Total		Date	Amount
Sept. 29	'50	Labor	39 00			<i>Sept. 24 '50</i>	<i>125 -</i>
Oct. 2	'50	"	7 00			<i>11/19/71</i>	<i>7</i>
		10% Overhead	4 60	50	60		<i>118 30</i>
		46' - 6" Sewer Pipe		12	88		<u>No Charge</u>
		1 - 6" Elbow		1	56	Oct. 2 '50	Labor 17 05
		Joint Compound		2	76		8' - 6" Sewer Pipe 2 24
		5 hrs. Brox Shovel		45	00		Joint Compound 48
		2 hrs. Trucking		1	50		1 hr. Brox Shovel 9 00
		Patching 4 x 3		4	00		Patching 8 x 3 8 00
				118	30		<u>36 77</u>
		Labor				<i>8/19/71</i>	<i>Roots</i>

TOWN OF LEXINGTON—DEPT. OF PUBLIC WORKS
SEWER DIVISION

DATE

NO.


The undersigned applies for the construction of a particular sewer connecting No.
Street and hereby agrees to comply with the Rules and Regulations governing the construction **and** use of Particular
Sewers, as now or at any future time established by the Board of Selectmen.

Am't of estimate \$.

Am't Paid \$.

..... Owner

Sketch of Service Here

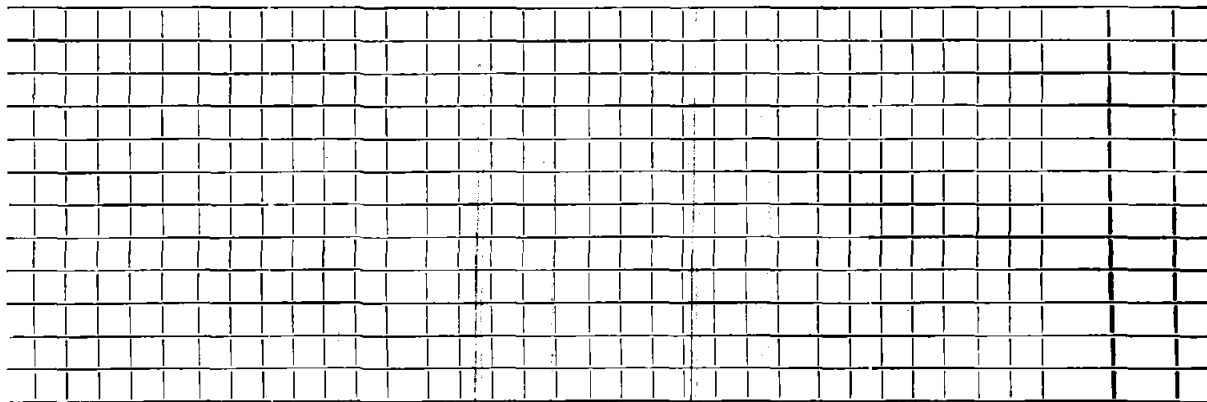

Connection made in Street.

Remarks:

Work completed 19..