

Name Edwin S L e e p e r

Service No. 146

Address 39 Farmcrest Avenue

W. O. #9165

Location

Kind of Pipe

Size

Size of Main

~~Repair/Revised~~ — **New Service**

Location

DEC 28 1964

Date	Material	Amount	Total	Date	Amount
-16-64	Labor	81 82		7-1-64	300 00
	10% O. H.	8 18	90 00	12-28-64	112 84
53'	6" Transite Pipe @.82		43 46		187 14
1	11 1/4 Bend		4 09		
1	22 1/2 Bend		4 09		
4	Yds. Loam @3.00		12 00		
1	Bag Cement		1 50		
4	Hrs. Town Shovel @6.50		26 00		
2	Hrs. Town Trucking @3.00		6 00		
			187 14		


DATE \_\_\_\_\_

TOWN OF LEXINGTON — BOARD OF PUBLIC WORKS

SEWER DIVISION

Sketch of Service Here

39

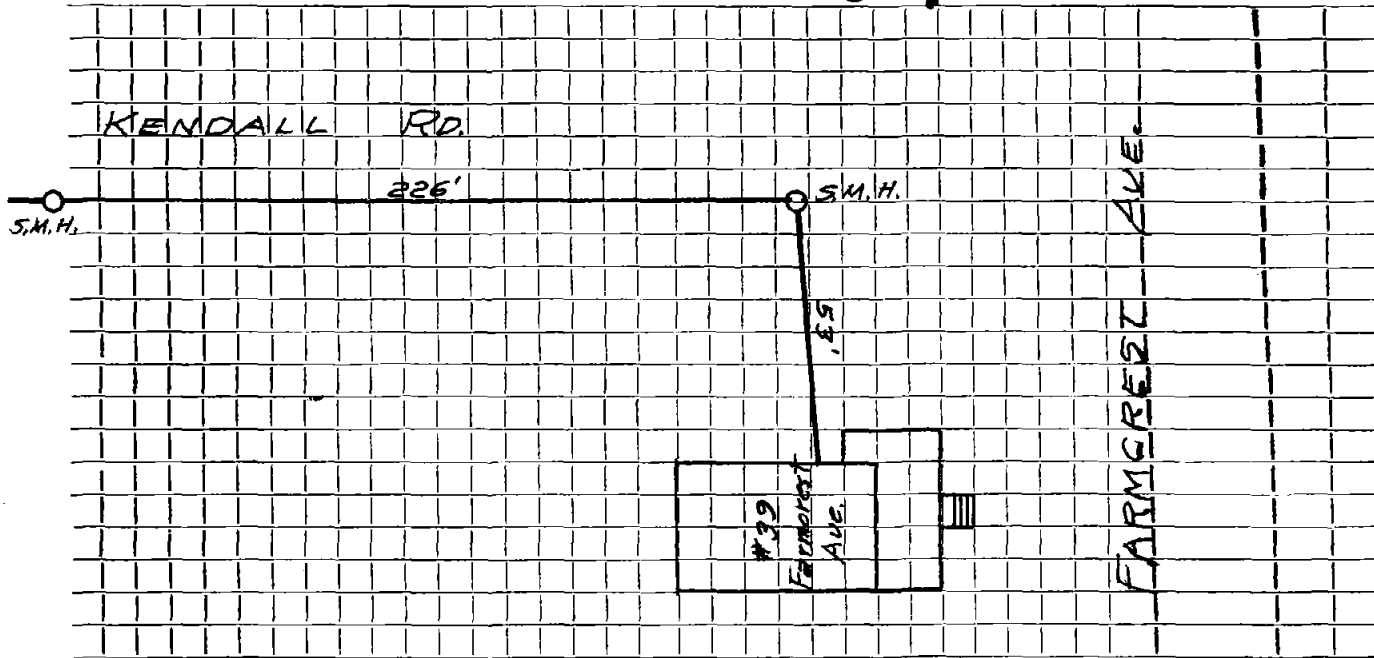

Connection made in ..... Street. Work completed .....

Remarks: .....

.....

.....