

Name John F. Downey

Service No. 128

Address 4 Farmercrest Avenue

Lexington, Mass.

Location 4 Farmercrest Avenue

Kind of Pipe

Size

Size of Main

~~Repair/ Renewal~~ — New Service

Com. 2-19-51

Location

Date	Material	Amount	Total	Date	Amount
26-51	Labor	16 90		Nov. 28 '51	100 00
27-51	Labor	3 60	20 50		21 50
	10% Overhead		2 05		78 97
	40' - 6" Sewer Pipe @.31/ft		13 76		
	2 - 6" Elbows @1.88		3 76		
	Joint Compound		2 40		
	Littlefield Shovel 5 hrs. @7.00		35 00		
	Truck lng 2 hrs. @.75		1 50		
			78 97		
	Labor				



TOWN OF LEXINGTON—DEPT. OF PUBLIC WORKS
SEWER DIVISION

DATE

NO.


The undersigned applies for the construction of a particular sewer connecting No.
 Street and hereby agrees to comply with the Rules and Regulations governing the construction **and** use of Particular
 Sewers, as now or at any future time established by the Board of Selectmen.

Am't of estimate \$.

Am't Paid \$.

..... Owner

Sketch of Service Here

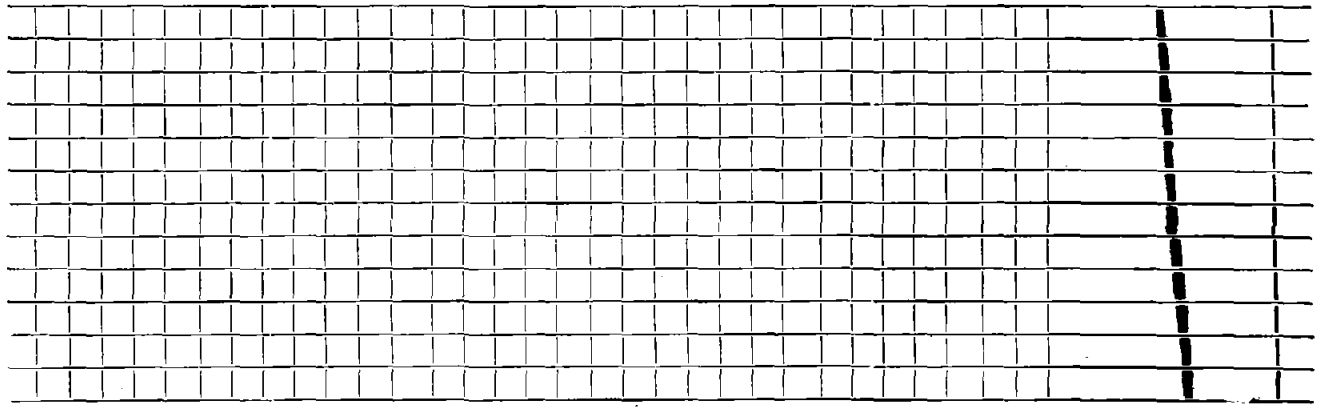

Connection made in Street.

Work completed .. - - - - - 19..

Remarks: