




DATE 8/12/94

TOWN OF LEXINGTON — BOARD OF PUBLIC WORKS  
SEWER DIVISION

Sketch of Service Here **41**

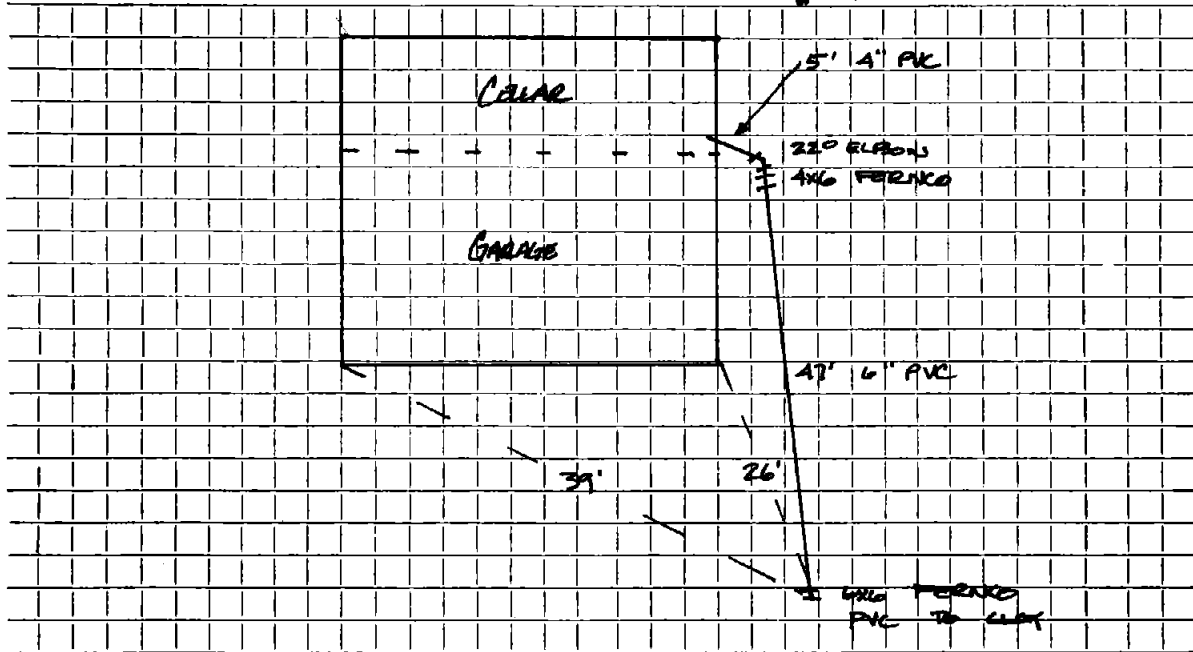

Connection made in ..... Street. Work completed .....

Remarks: .....

.....

.....