


DATE 5/29/19

TOWN OF LEXINGTON — BOARD OF PUBLIC WORKS
SEWER DIVISION

Sketch of Service Here

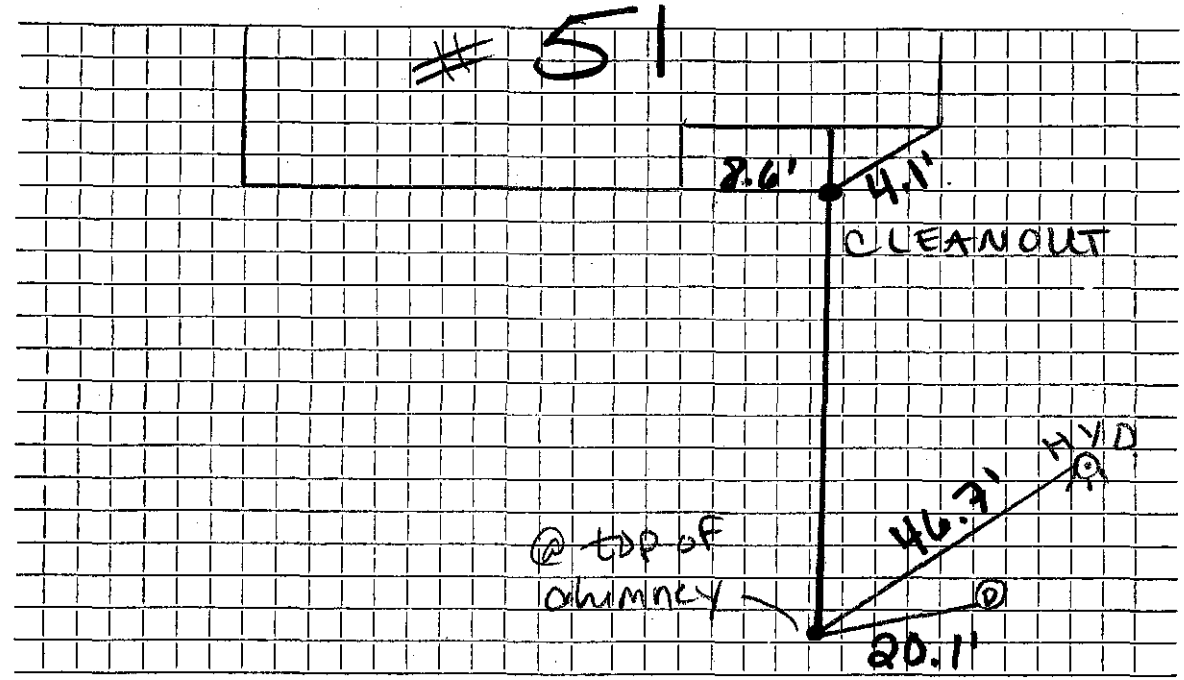

Connection made in Farmcrest Ave Street. Work completed

Remarks: Sewer connection @ top of chimney depth = 5.5'
Chimney depth = 11'

Name Contractor: Iovino

Service No.

Address 51 Farmcrest Ave

Location

Kind of Pipe SDR 35 PVC

Size 6"

Size of Main

Repair—Renewal—New Service

Location

Date	Material	Amount	Total	Date		Amount
------	----------	--------	-------	------	--	--------

5/25/19

4" SDR 21 PVC
Cleanout

4x6" FarnCo

6" SDR 35 PVC

↳ Connect to
existing SMH
chimney
(depth of
connection = 5.5')

depth of
chimney = 11'