

Name Mr. & Mrs. S. E. Lund

Service No. 8

Address 62 Framcrest Avenue

Location

Kind of Pipe

Size

Size of Main

~~Repair~~ Renewal — New Service

Eagle # ~~XXXX~~ 977 W.O. 6511

Location AUG 5 1968

Date	Material	Amount	Total	Date	Amount
4/23/68	Labor	122 29		3-29-68	175 00
5/10/68	Labor	15 06		8-2-68	36 84
5/17/68	Labor	5 02	142 37		211 84
	10% O.H.	14 24	14 24		
	10' 6" transite @ .88		8 80		
	5' 6" transite @ .88		4 40		
	1 8±6 Saddle		5 50		
	1 elbow		2 35		
	1 6" nipple		68		
	4 hrs. trucking @3.00		12 00		
	2 hrs. shovel @6.50		13 00		
	1 hr. compressor		5 00		
	½ hr. roller 1.50 & trailer 2.00		3 50		
			<u>211 84</u>		
	TOTAL COST 211 84				
4-29-68	42' 6" Transite pipe				
	10' 4" Cast Iron pipe				

*Deposit Paid*


*3684*

DATE \_\_\_\_\_

TOWN OF LEXINGTON — BOARD OF PUBLIC WORKS  
SEWER DIVISION

Sketch of Service Here

62

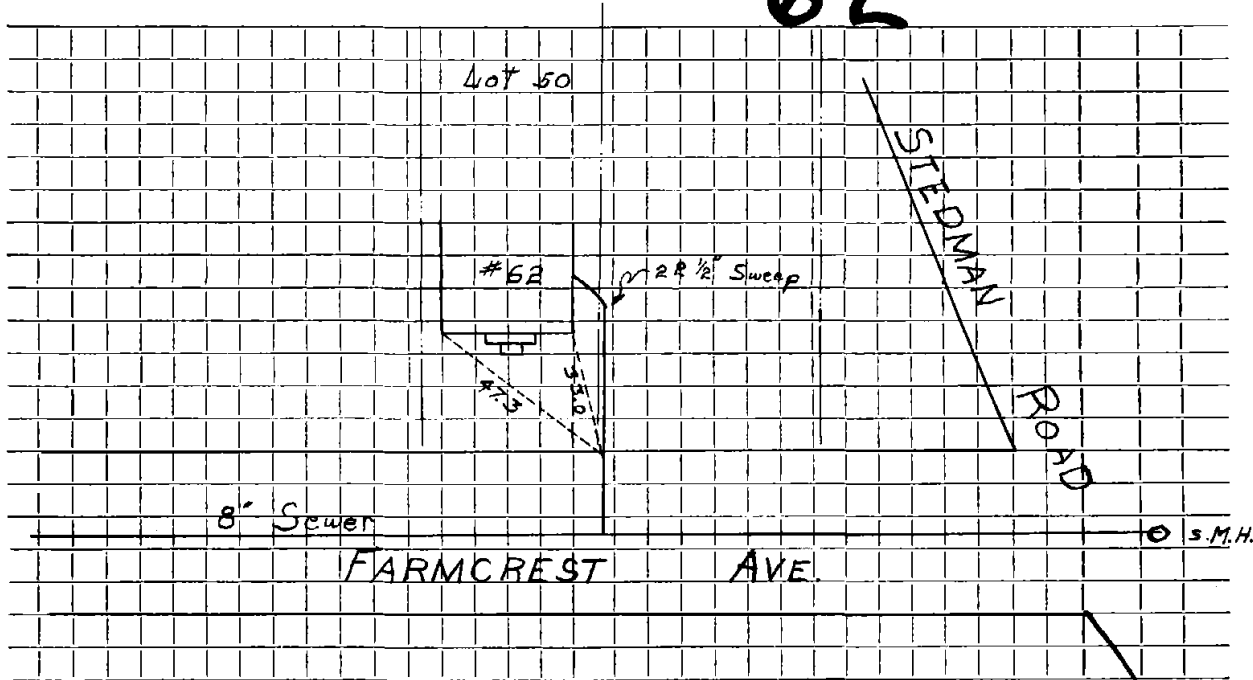

Connection made in ..... Street. Work completed .....

Remarks: .....

.....

.....