

Name Ernest Lindstrom

Service No. 93

Address 63 Farmcrest Avenue

Lexington

Location 63 Farmcrest Avenue

Kind of Pipe

Size

Size of Main

~~Repair - Renewal~~ New Service

Com. 11-6-50

Location

Date	Material	Amount	Total	Date	Amount
Oct. 4 '50	Labor	57 65		Oct. 2 '50	150 —
Oct. 5 '50	Labor	17 00			161 —
	10% Overhead	7 47	82 12		141 32
	46' — 6" Sewer Pipe		12 88		
	1 - 6" Elbow		1 56		No Charge
	Joint Compound		2 76	Oct. 5 '50	Labor 17 30
	4 hrs. Brox Shovel		36 00		8' - 6" Sewer Pipe 2 24
	2 hrs. Trucking		1 50		Joint Compound 48
	2 hrs. Hough Loader		50		1 hr. Brox Shovel 9 00
	Patching 4 x 3		4 00		Patching 8 x 3 8 00
			141 32		37 02
	Labor				

TOWN OF LEXINGTON—DEPT. OF PUBLIC WORKS
SEWER DIVISION

DATE

NO.


The undersigned applies for the construction of a particular sewer connecting No.
Street and hereby agrees to comply with the Rules and Regulations governing the construction **and** use of Particular
Sewers, as now or at any future time established by the Board of Selectmen.

Am't of estimate \$.....

Am't Paid \$.....

..... Owner

Sketch of Service Here

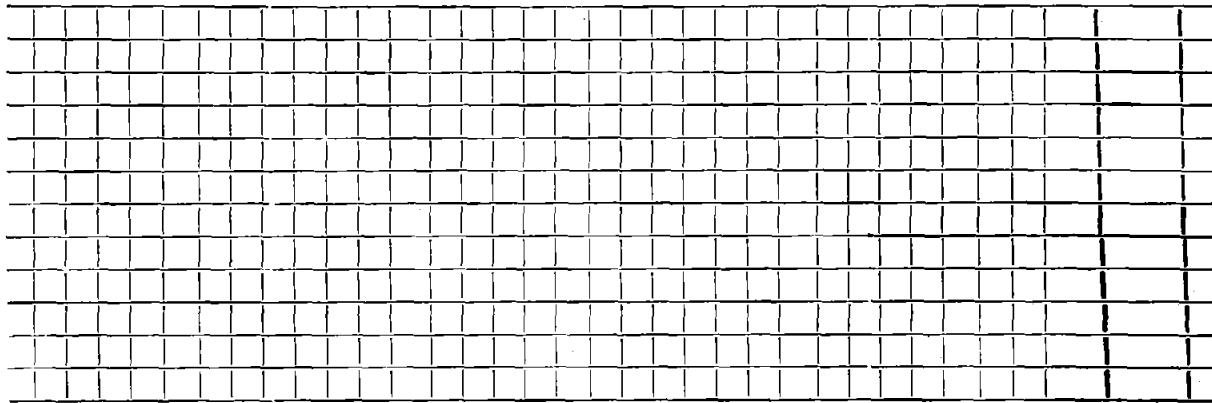

Connection made in Street.

Work completed

19..

Remarks: