

Name Paul F. Devereaux

Service No. 194

Address 21 Fern Street, Lexington

Location

Kind of Pipe

Size

Size of Main

~~Repair~~ ~~Renewal~~

New Service

Valeri #938
W.O. # 6049


Location AUG 5 1968

Date		Material	Amount	Total	Date	Amount
12/27/67		Labor	78 18		<i>Deposit</i>	150 00
3/27/67		Labor	11 26			
		Labor	13 01			
		10% O. H.	10 25	112 70		
	17'	6" transite @.88		14 96		
	1	saddle		5 50		
	1	6" nipple		65		
	1	adapter		2 76		
	1	90° elbow		4 09		
	1	ton hot top		5 80		
	3½	hrs. trucking @ 3.00		10 50		
	3	hrs. compressor @ 5.00		15 00		
	4	hrs. shovel @ 6.50		26 00		
	½	hr. roller & trailer		3 50		
		TOTAL COST		201 46		
1-19-68	41'	6" Transite pipe			<i>Bill 51.76</i>	
	10'	4" Cast Iron pipe				

DATE _____

TOWN OF LEXINGTON — BOARD OF PUBLIC WORKS
SEWER DIVISION

Sketch of Service Here **21**

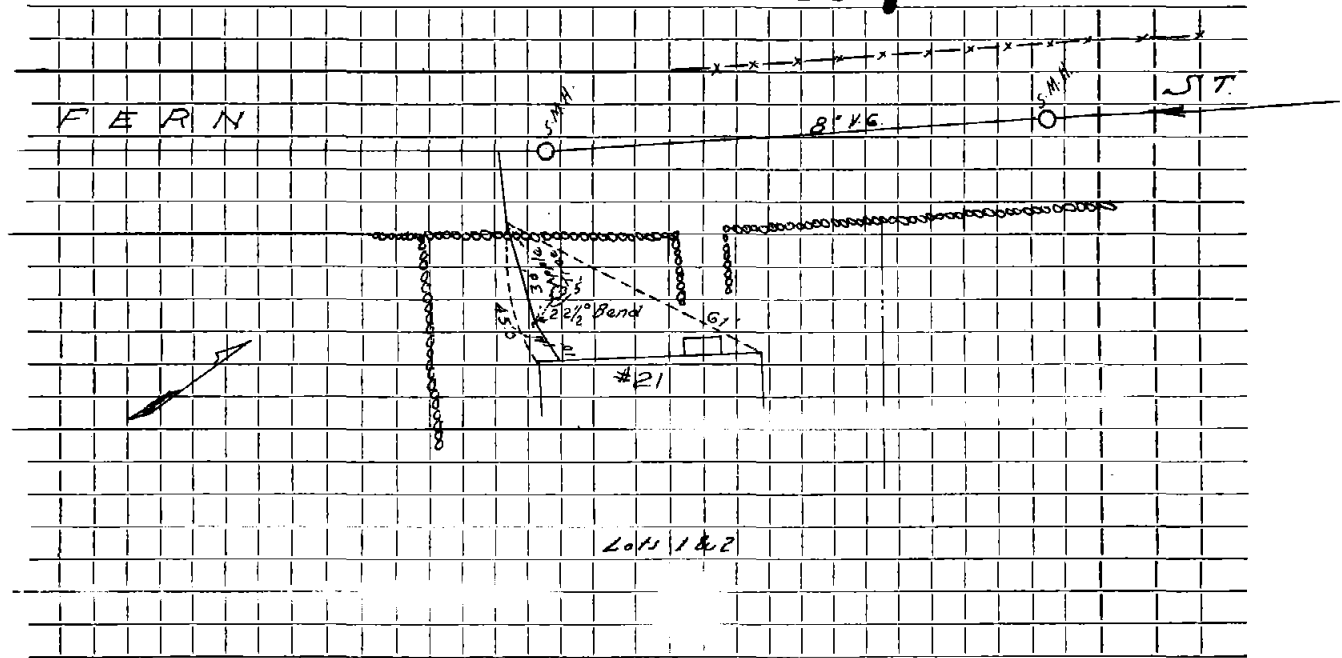

Connection made in Street. Work completed

Remarks:

.....

.....