


DATE 1/3/95

TOWN OF LEXINGTON — BOARD OF PUBLIC WORKS

SEWER DIVISION

Sketch of Service Here

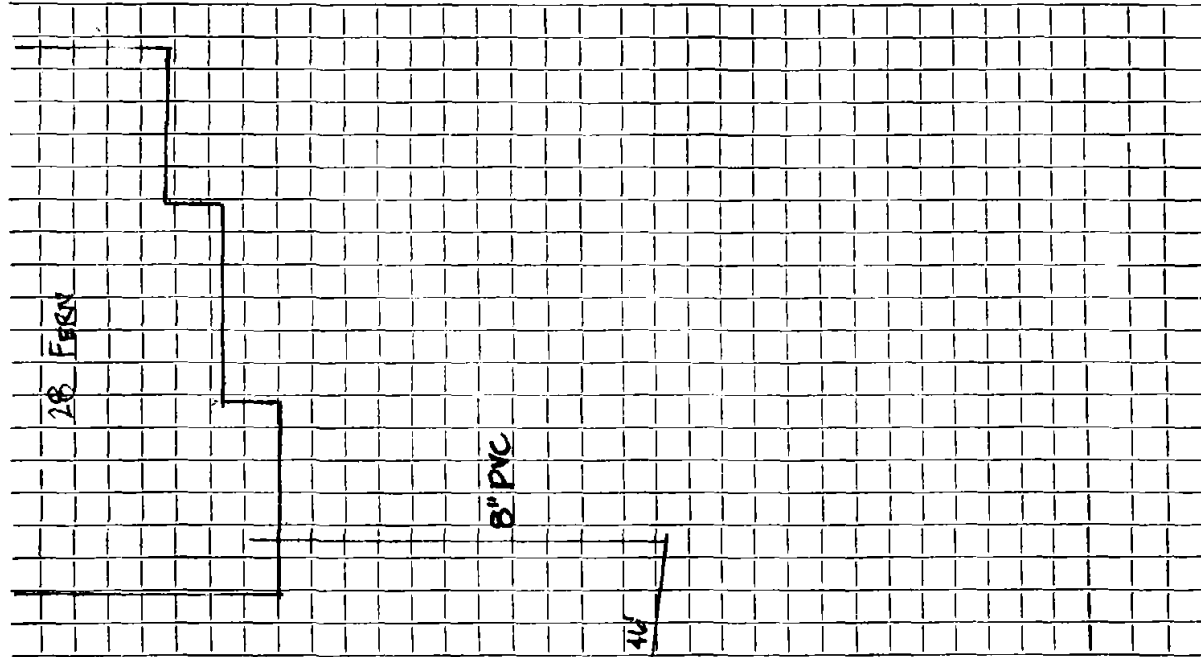


Connection made in Street. Work completed

Remarks:

.....

.....

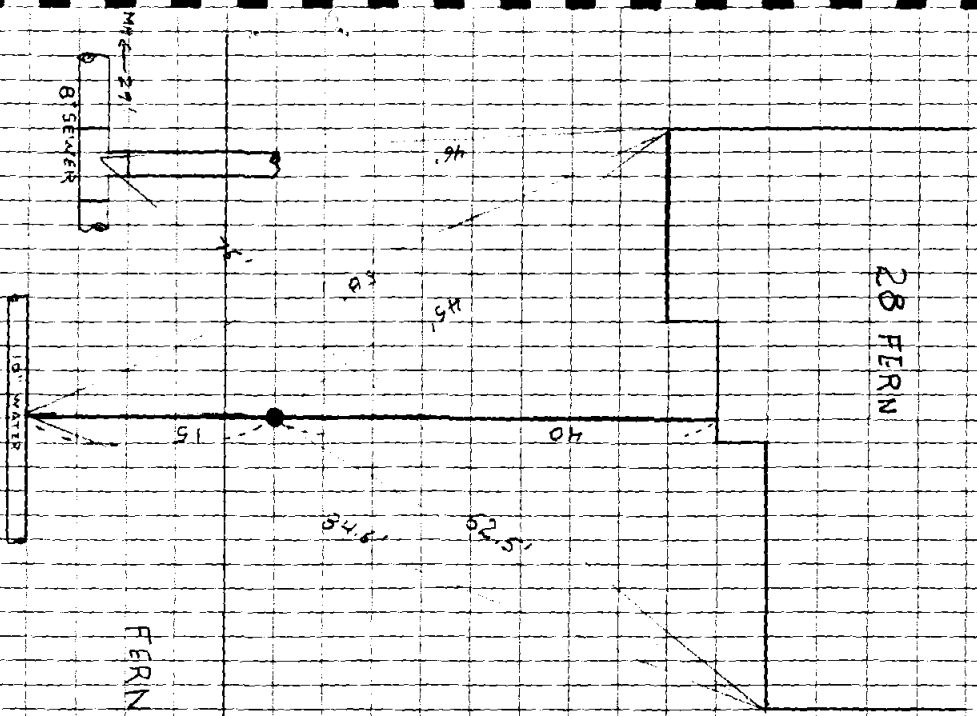

8" SEWER
 27'

18" WATER

FERN ST.

28 FERN

①