


DATE 06/11/24

TOWN OF LEXINGTON — BOARD OF PUBLIC WORKS
SEWER DIVISION

Sketch of Service Here
32 Fern St.

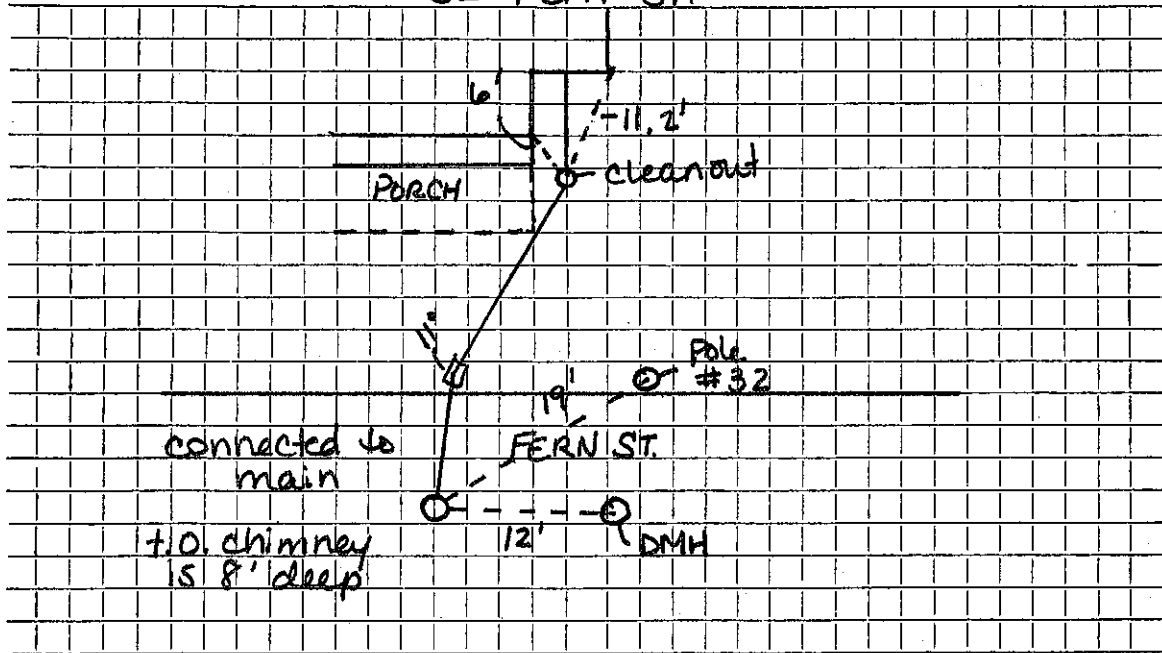

Connection made in Street. Work completed

Remarks: Installed by Rafaele Construction Corps.