

Name Donald Wilson

Service No. 77

Address 36 Fern Street

Location

Kind of Pipe

Size

Size of Main

Repair—Renewal—New Service Eagle #686 W.O.# 4964

Location

Date	Material	Amount	Total	Date	Amount
7-11-67	40' 6" Transite pipe			6-28-67	150 00
	29' 4" Cast Iron pipe			4-8-68	270 45
6-28-67	Labor 109.84				420 45
7-5-67	" 123.44				
7-7-67	" 5.03	238.31			
	10% O.H.	23.83	262.14		
	25' 6" Transite pipe @.88		22.00		
	1 6" Plug		1.33		
	½ bag cement @1.55		.78		
	8 ton Fill @.70		5.60		
	36 Sticks dymanite @.27		9.72		
	16 Caps dymanite @.33		5.28		
	9 hrs. Town Shovel @6.50		58.50		
	2 hrs. Dozer @4.00		8.00		
	9 hrs. Trucking @3.00		27.00		
	1 hr. Trailer @2.00		2.00		
	½ hr. Roller @3.00		1.50		
	1 hr. Compressor		5.00		
			420.45		

Deposit
Paid

D. Wilson


DATE _____

TOWN OF LEXINGTON — BOARD OF PUBLIC WORKS

SEWER DIVISION

Sketch of Service Here

36

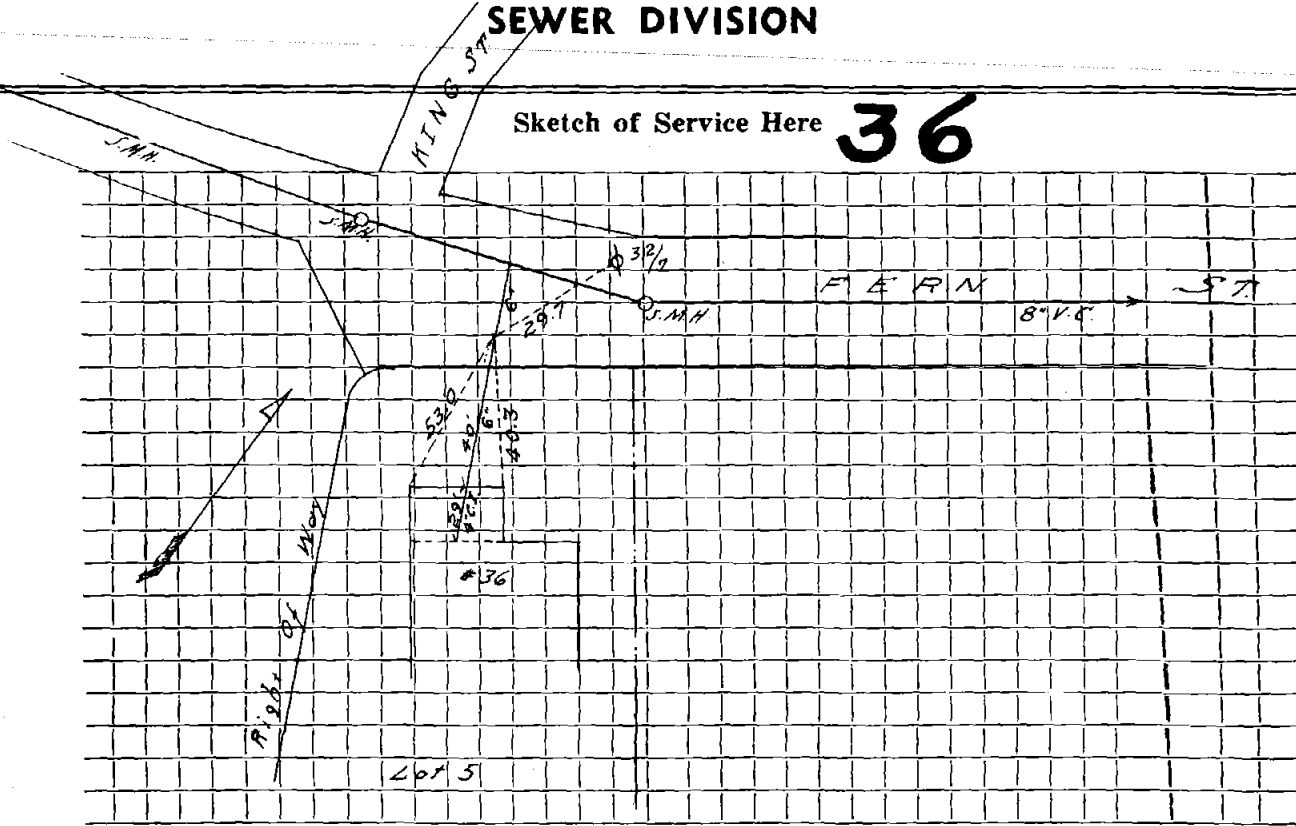

Connection made in Street. Work completed

Remarks:

.....