

Name

*Leopold*

Service No.

Address *38*

*FERN ST.*

Location

Kind of Pipe

Size

Size of Main

Repair—Renewal—New Service

*Bank's # 2271*

Location

Date

Material

Amount

Total

Date

Amount

*9/2/93*

*3 LF 4" CI*

*104 LF 6" PVC*

*6x6" WYE C.O.*


*4"x6" FERNCO*

*3- 6" 45° ELBOWS*

DATE 1/5/93

TOWN OF LEXINGTON — BOARD OF PUBLIC WORKS  
SEWER DIVISION

Sketch of Service Here 38

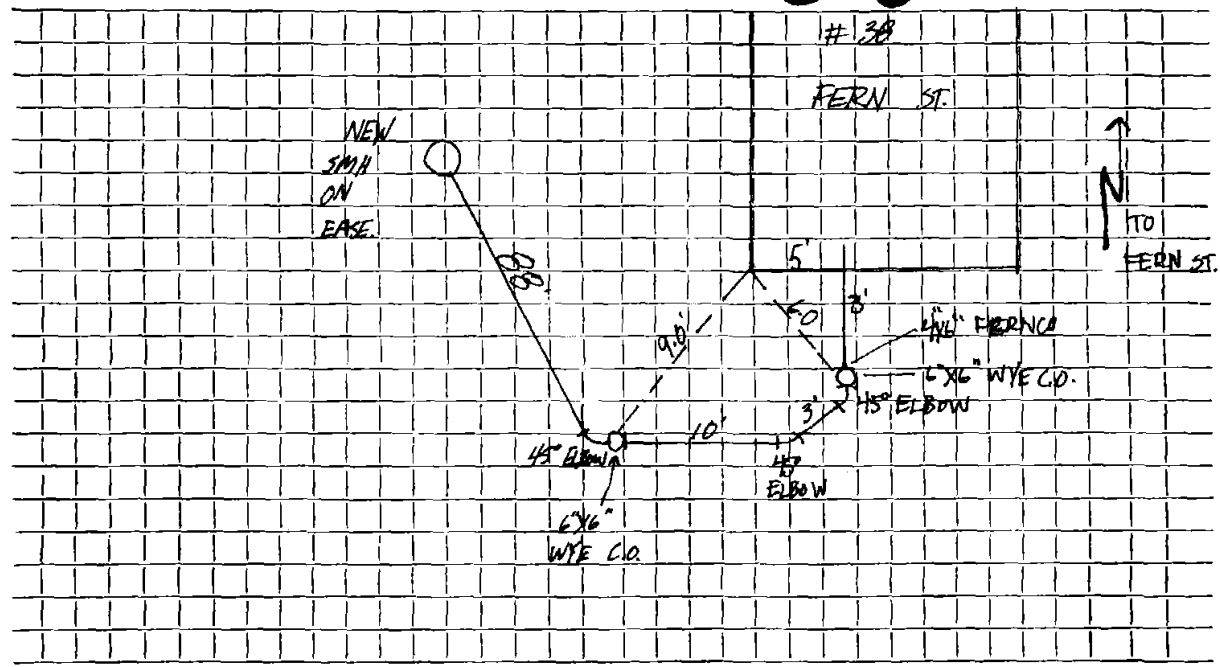

Connection made in ..... Street. Work completed 9/2/93 E.R. BANKS.....

Remarks: .....  
.....  
.....