

Name Mrs. Moore

Service No. 64

Address 43 Fern Street

Lexington

Location

Kind of Pipe

Size

Size of Main

~~Repair~~ — New Service COM. 7-28-52

Location

Date	Material	Amount	Total	Date	Amount
7/7/52	Labor	43 74		5-3-52 Deposited	125 00
	10% overhead	4 37	48 11	7-28-52 Refunded	(8 04
	36' - 6" sewer pipe @ .342		12 31		116 96
	1 - 6" elbow		1 88		
	joint compound		2 16		
	6 hrs. Littlefield shovel		42 00		
	2 hrs. trucking		1 50		
	patching 9 x 3		9 00		
			116 96		
	Labor			11-22-67 Proto	
				5-9-91 Respond + Measure (Rd)	
				10-15-98 Blockage About 36' OUT	

TOWN OF LEXINGTON—DEPT. OF PUBLIC WORKS
SEWER DIVISION

DATE.....

NO.


The undersigned applies for the construction of a particular sewer connecting No.....
Street and hereby agrees to comply with the Rules and Regulations governing the construction and use of Particular
Sewers, as now or at any future time established by the Board of Selectmen.

Am't of estimate \$.....

Am't Paid \$.....

..... Owner

Sketch of Service Here

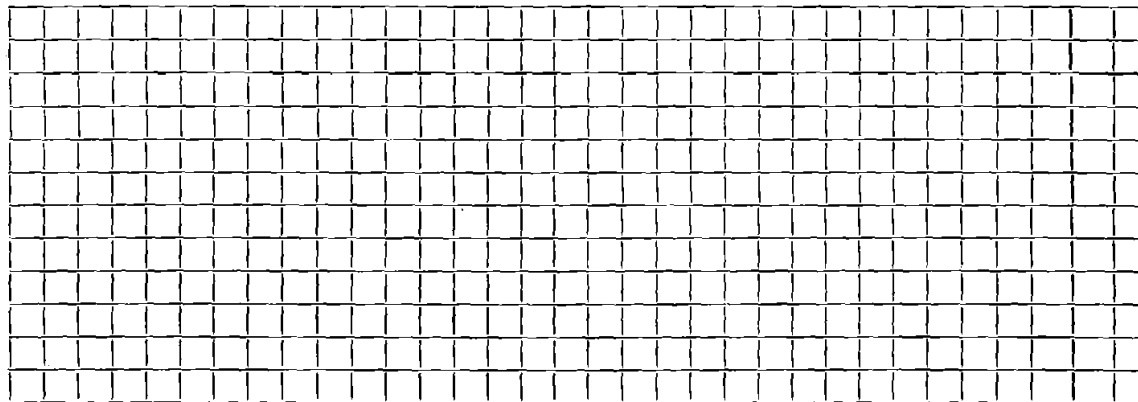

Connection made in..... Street.

Work completed.....19..

Remarks: