




DATE \_\_\_\_\_

TOWN OF LEXINGTON — BOARD OF PUBLIC WORKS

SEWER DIVISION

Sketch of Service Here **47**

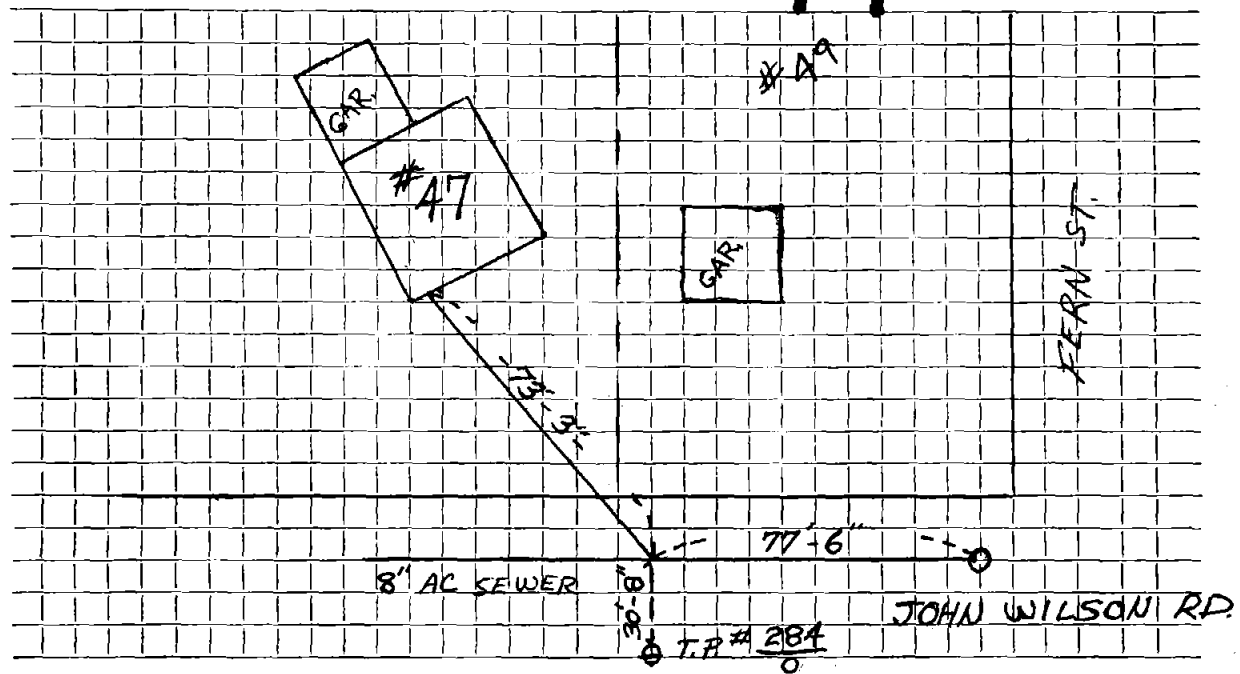

Connection made in ... JOHN WILSON LANE Street.

Work completed .....

Remarks: .....

.....