

Name **Philip Silva**

Service No. **107**

Address **7 Fern Street**

Lexington, Mass.

Location **7 Fern Street**

Kind of Pipe

Size

Size of Main

~~Repair/Removal~~ **New Service**

Com. **12-31-50**

Location

Date

Material

Amount

Total

Date

Amount

Date	Material	Amount	Total	Date	Amount
Nov. 7, '50	Labor	31 63		Nov 7 '50	125 20
Nov. 8, '50	Labor	6 13	37 76		
	10% Overhead		3 78		90 95
	30' - 6" Sewer Pipe		8 40		
	Joint Compound		1 85		
	Littlefield Shovel 3 hrs. @ 7.00		21 00		
	Hough Loader 2 hrs. @ 3.00		6 00		
	Trucking 2 hrs. @ .75		1 50		
	Patching 8 x 3		10 66		
			90 95		
	Labor				

TOWN OF LEXINGTON—DEPT. OF PUBLIC WORKS

SEWER DIVISION

DATE

NO.


The undersigned applies for the construction of a particular sewer connecting No. Street and hereby agrees to comply with the Rules and Regulations governing the construction and use of Particular Sewers, as now or at any future time established by the Board of Selectmen.

Am't of estimate \$.....

Am't Paid \$.....

..... Owner

Sketch of Service Here

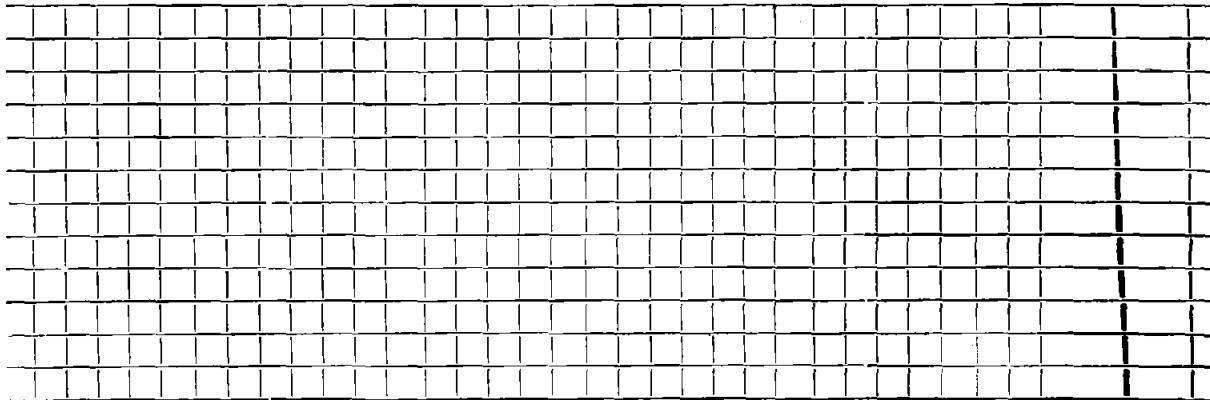

Connection made in Street.

Work completed .. - 19..

Remarks: