

Name Curt Sternweiller

Service No. 70

Address 11 Fessenden Way

Location Lot 24

Kind of Pipe

Size

Size of Main

Repair—Renewal—New Service

Valve # 2864

Location OCT 25 1976

Date Material Amount Total Date Amount

1974	31'	6" Transite @ 9.00	279.00		8-18-74	Deposit	279.00
-----------------	----------------	-------------------------------	-------------------	--	--------------------	---------	-------------------

1970
31' 6" Transite


DATE _____

TOWN OF LEXINGTON — BOARD OF PUBLIC WORKS

SEWER DIVISION

Sketch of Service Here

11

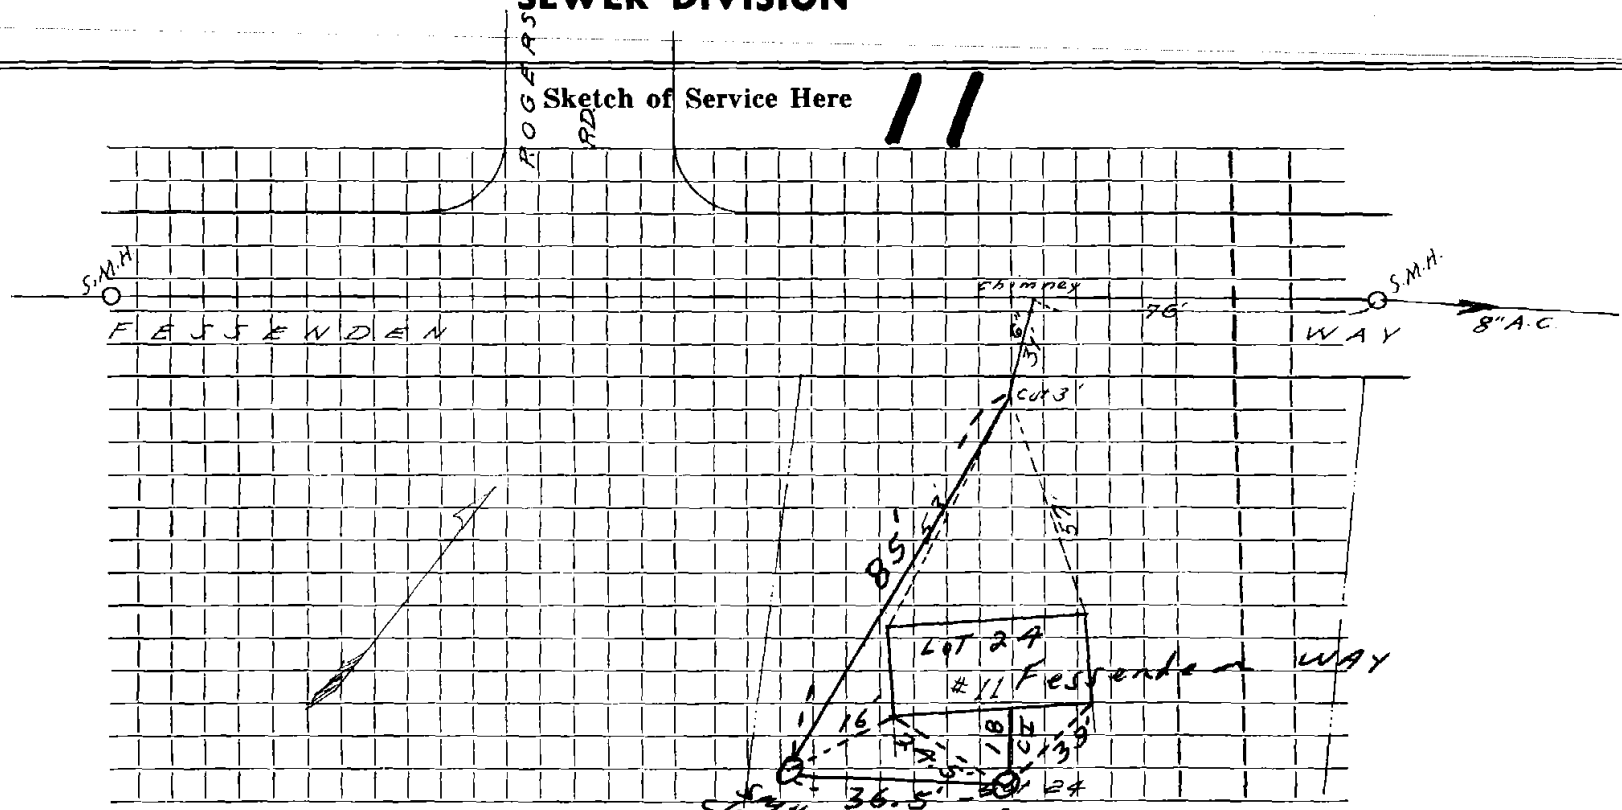

Connection made in Street. Work completed S.M.H. Clean-out

Remarks:

.....

.....