

Name Jerome Bressman

Service No. 32

1977

Address 4 Fessenden Way

Location Lot 7

JUN 20 1977

Kind of Pipe

Size

Size of Main

~~REPAIR~~ New Service

Valeri #3290

Location

Date

Material

Amount

Total

Date

Amount

|      |                        |           |  |  |         |         |                   |
|------|------------------------|-----------|--|--|---------|---------|-------------------|
| 1970 | 28' 6" Transite @ 9.00 | \$ 252.00 |  |  | 5/26/77 | Deposit | <del>352.00</del> |
|------|------------------------|-----------|--|--|---------|---------|-------------------|

|        |                      |  |  |  |  |  |  |
|--------|----------------------|--|--|--|--|--|--|
| 6/3/77 | 91' 6" transite pipe |  |  |  |  |  |  |
|--------|----------------------|--|--|--|--|--|--|


1970

28' 6" Transite

DATE \_\_\_\_\_

TOWN OF LEXINGTON — BOARD OF PUBLIC WORKS  
SEWER DIVISION

**4** Sketch of Service Here

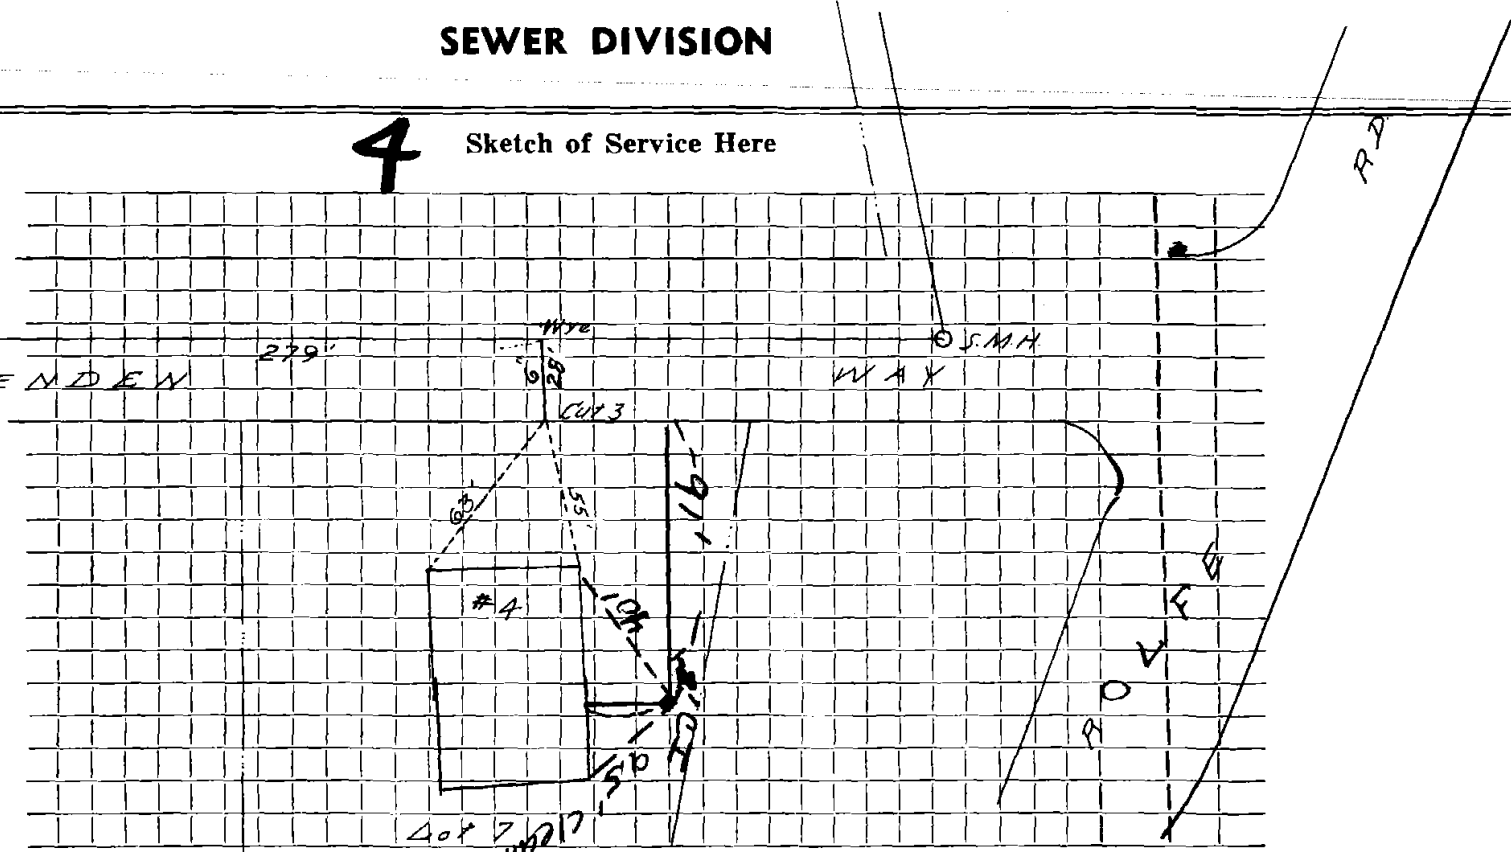

Connection made in ..... Street. Work completed .....

Remarks: .....  
.....  
.....