


DATE _____

TOWN OF LEXINGTON — BOARD OF PUBLIC WORKS

SEWER DIVISION

Sketch of Service Here

7

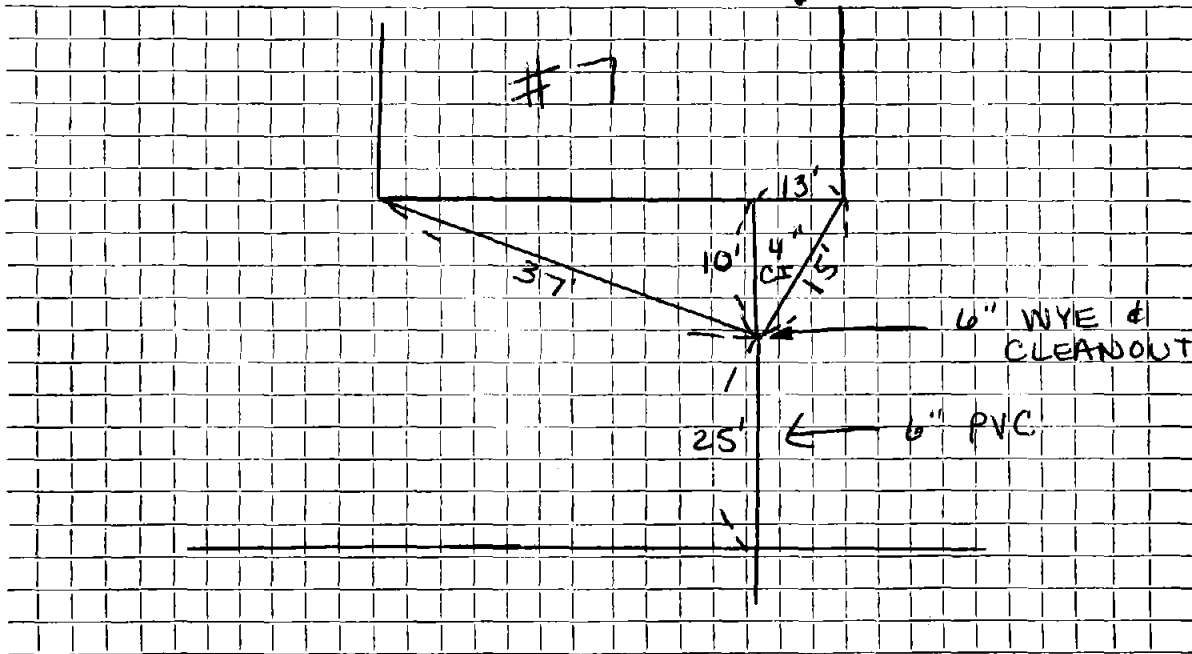

Connection made in Fessenden Way Street.

Work completed

Remarks:
.....
.....