


DATE _____

TOWN OF LEXINGTON — BOARD OF PUBLIC WORKS

SEWER DIVISION

Sketch of Service Here

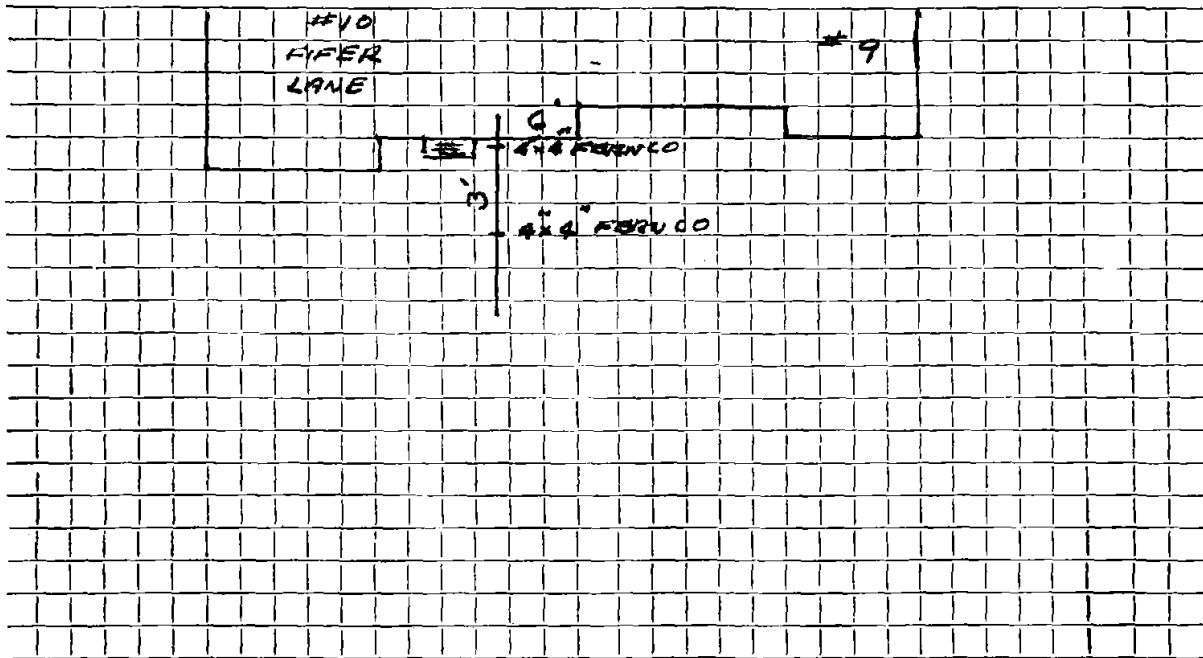

Connection made in PARKING AREA Street. Work completed

Remarks: REPAIR

.....
.....