

Name Arthur Gerstenfeld

Service No. 103

Address 10 Field Road

Lot L.C. 52

Location

Kind of Pipe

Size

Size of Main

Repair—Renewal—**New Service** Valeri #1969

Location APR 26 1972


Date		Material	Amount	Total	Date		Amount
1971	31	6" Transite pipe @12.00		372.00	11-8-71	Deposit	372.00
11-30-71	64	6" Transite pipe					
	20	4" Cast Iron pipe					
					1971		
					31	6" Transite	
					1	6"-30° Bend	

DATE _____

TOWN OF LEXINGTON — BOARD OF PUBLIC WORKS

SEWER DIVISION

Sketch of Service Here **10**

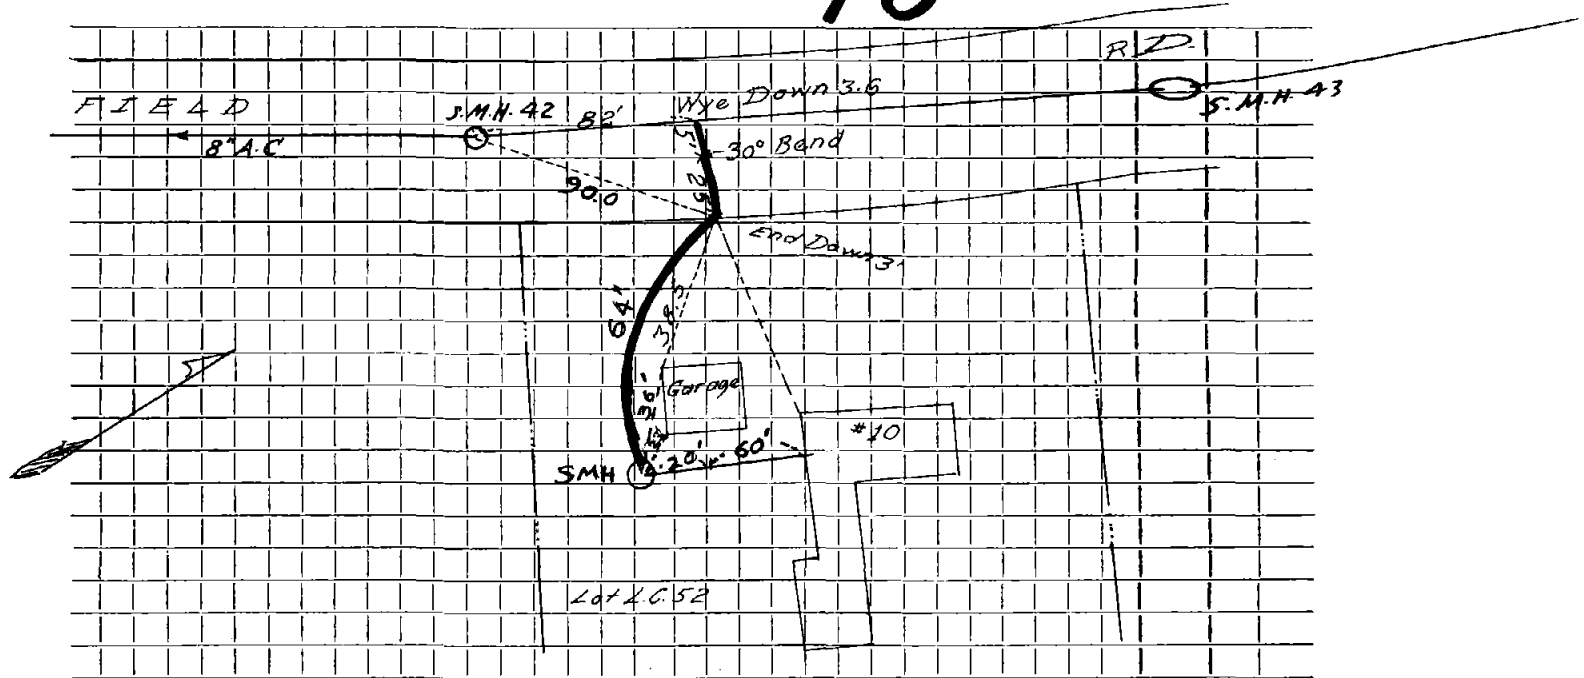

Connection made in Street. Work completed

Remarks:
.....
.....