

Name

Service No.

Address

11 Fields Rd

Location

Kind of Pipe

Size

Size of Main

Repair—Renewal—New Service

Location

Date

Material

Amount

Total

Date

Amount


2-10-06

10' - 4" PVC pipe
84' - 6" PVC pipe
4x6 PVC to PVC Franco
6x6 PVC to AC Franco
2 6x6x6 wye elbows

DATE _____

TOWN OF LEXINGTON — BOARD OF PUBLIC WORKS
SEWER DIVISION

Sketch of Service Here

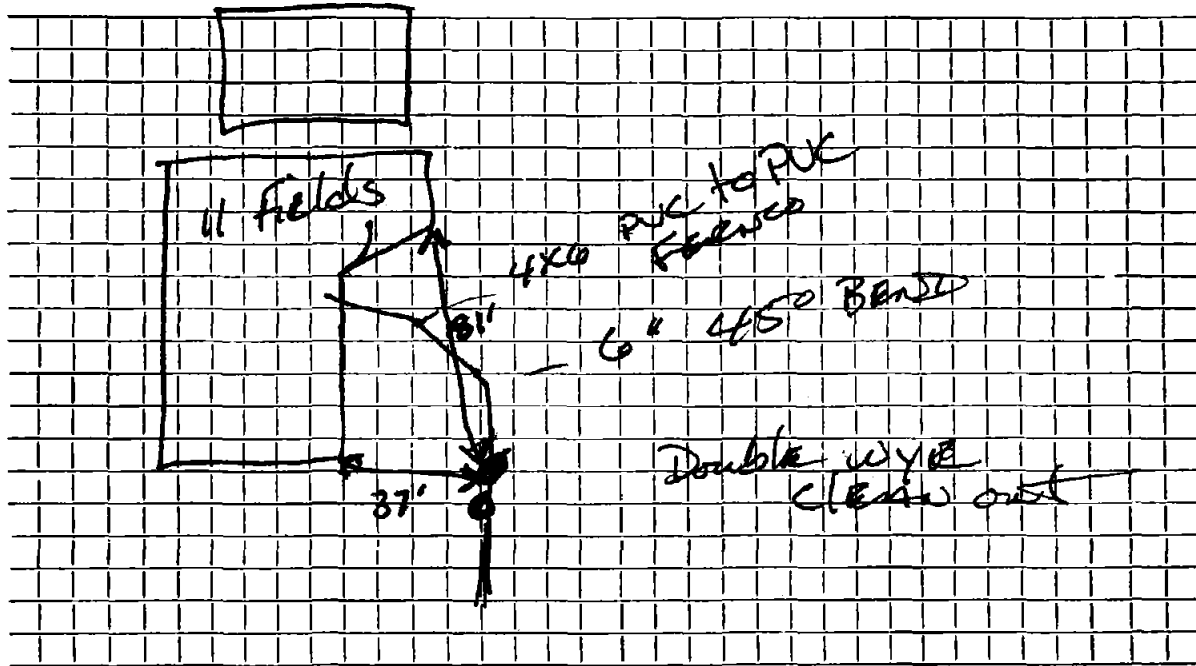

Connection made in _____ Street. Work completed _____

Remarks: Service goes out to EASEMENT
behind the house