




DATE \_\_\_\_\_

TOWN OF LEXINGTON — BOARD OF PUBLIC WORKS  
SEWER DIVISION

A.V.E.

Sketch of Service Here **2**

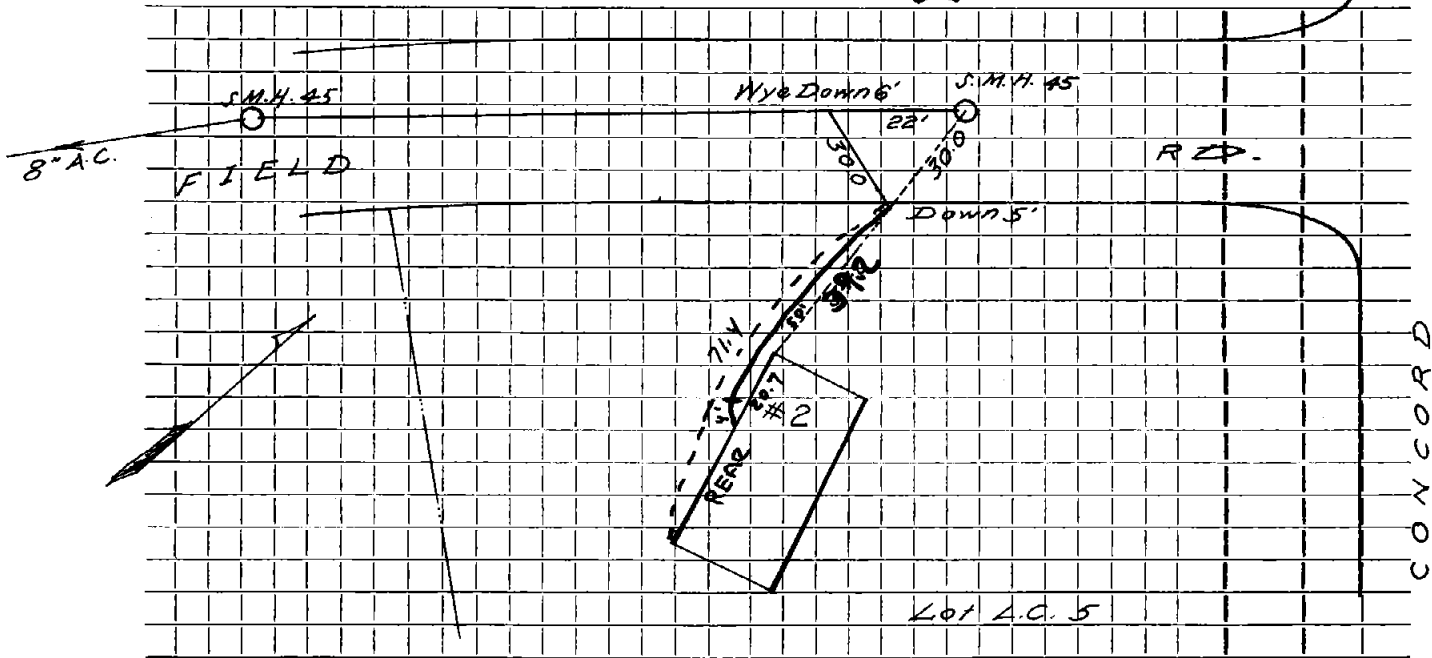

Connection made in ..... Street. Work completed .....

Remarks: .....

.....  
.....