


DATE _____

TOWN OF LEXINGTON — BOARD OF PUBLIC WORKS

SEWER DIVISION

Sketch of Service Here **5**

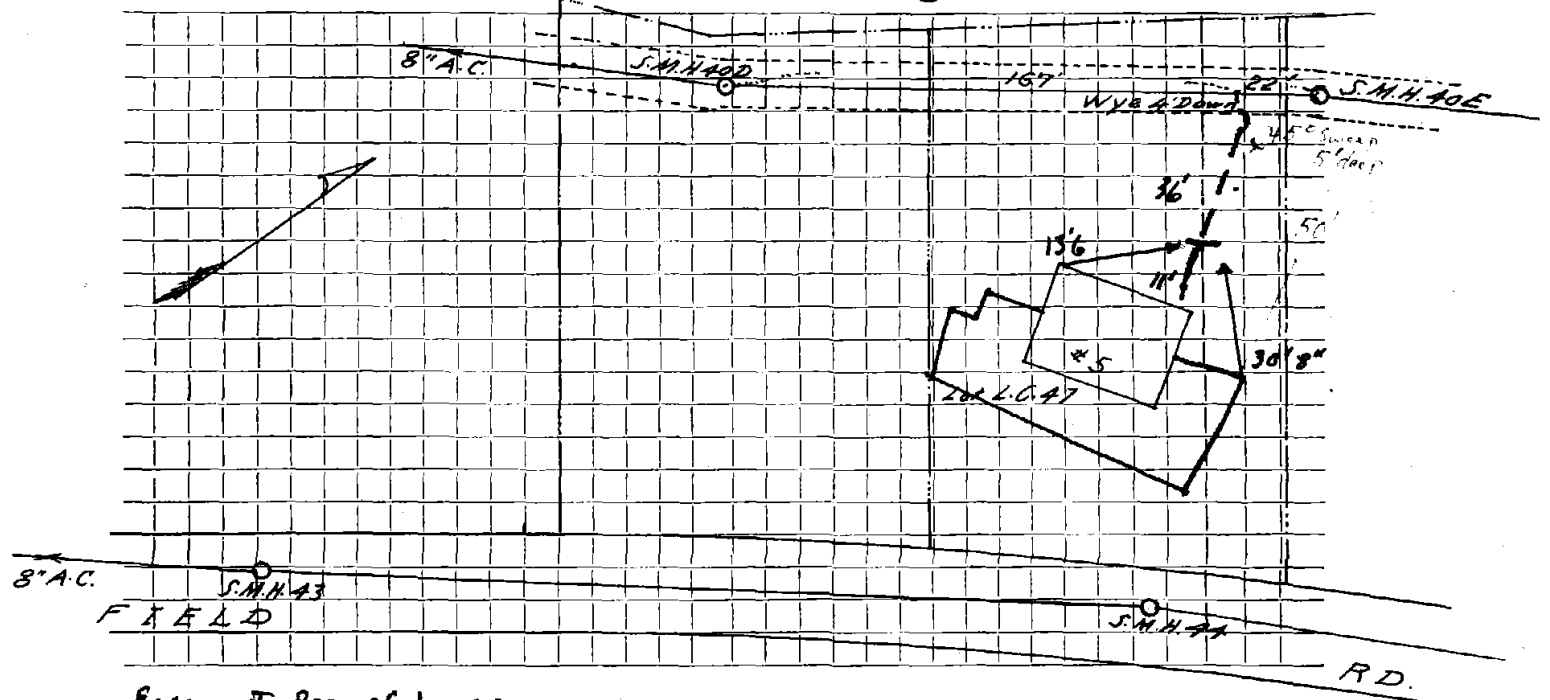

Connection made in Easement Recv of house... Street. Work completed.....

Remarks: Connection made, 6" PVC to 4" orange hvy. Pipe - NOT Approved by Town

.....
.....