

Name Paul Riffin

Service No. 112

Address 6 Field Road

Location

Kind of Pipe

Size

Size of Main

Repair—Renewal—**New Service** Valeri #1962

Location APR 26 1972


| Date | Material | Amount | Total | | Date | Amount | |
|-----------------|-----------------------------------------|--------|-------|--------|-----------------|---------|--|
| 1971 | 26' 6" Transite pipe @12.00' | | | 312.00 | 1/15/72 | Deposit | |
| 1-20-71 | 65' 6" Transite pipe | | | | | | |
| | 61' 4" Cast Iron pipe | | | | 1971 | | |
| | | | | | 26' 6" Transite | | |
| | | | | | 1 6"-22° Bend | | |

DATE _____

TOWN OF LEXINGTON — BOARD OF PUBLIC WORKS

SEWER DIVISION

Sketch of Service Here **6**

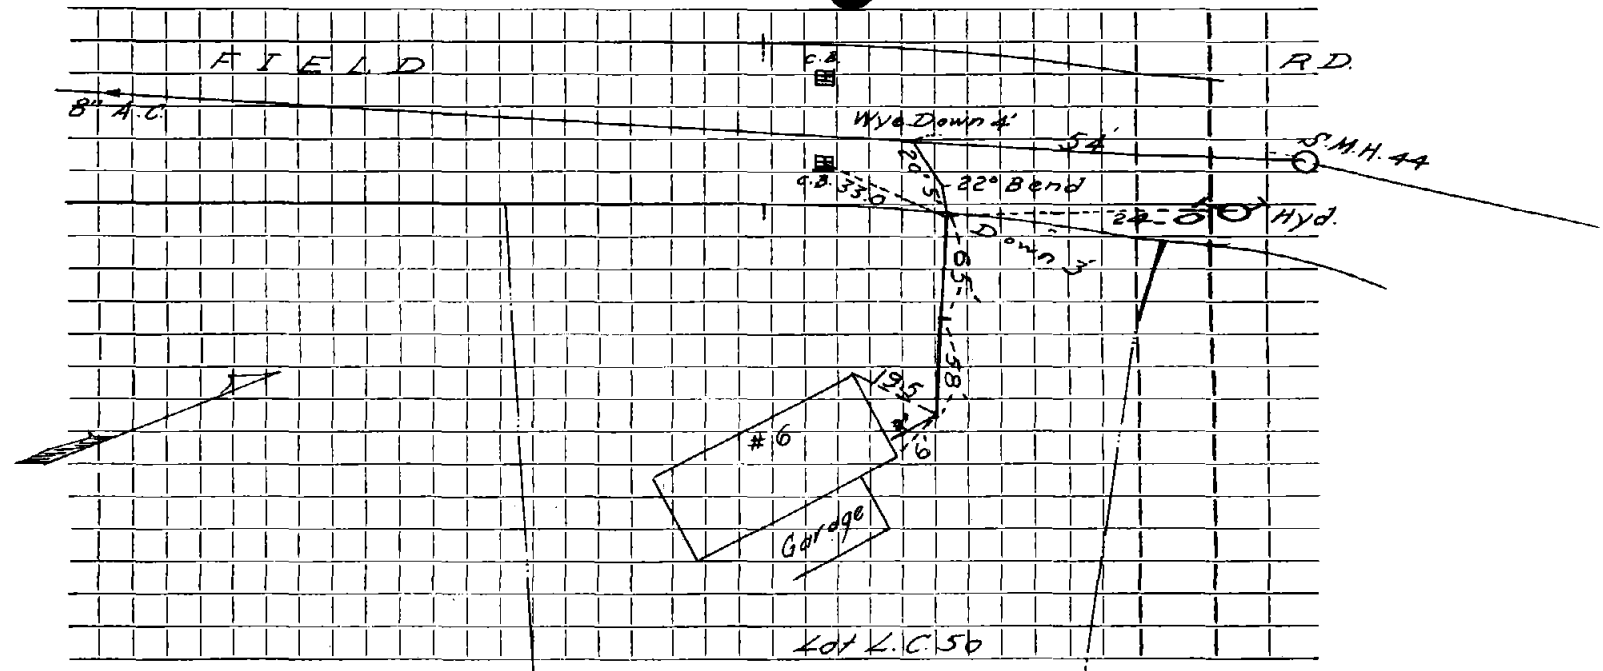

Connection made in Street. Work completed

Remarks:
.....
.....