

Permit

Service No. 3886

Name

Address 9 Field-RD

Location

PG 11-LOT 66

Kind of Pipe

Size

Size of Main

Repair—Renewal—New Service

J. McLaughlin

Location


Date	Material	Amount	Total	Date	Amount
10/15/10	1.0" 4" PVC @ Foundation				
	1 4" Clearout sch 40				
	5.4" 4" sch 40				
	1 4x6 Ferroco				
	80' 6" PVC				
	1 6" PVC-Clearout				
	1 6" PVC x AC-Ferroco				
	Exst 5" sch AC-3.6" DWV				
11-18-71	AC-PIPE				
	8x6 Wye-4' DWV				
	8" AL MAIN				

DATE \_\_\_\_\_

TOWN OF LEXINGTON — BOARD OF PUBLIC WORKS

SEWER DIVISION

Sketch of Service Here

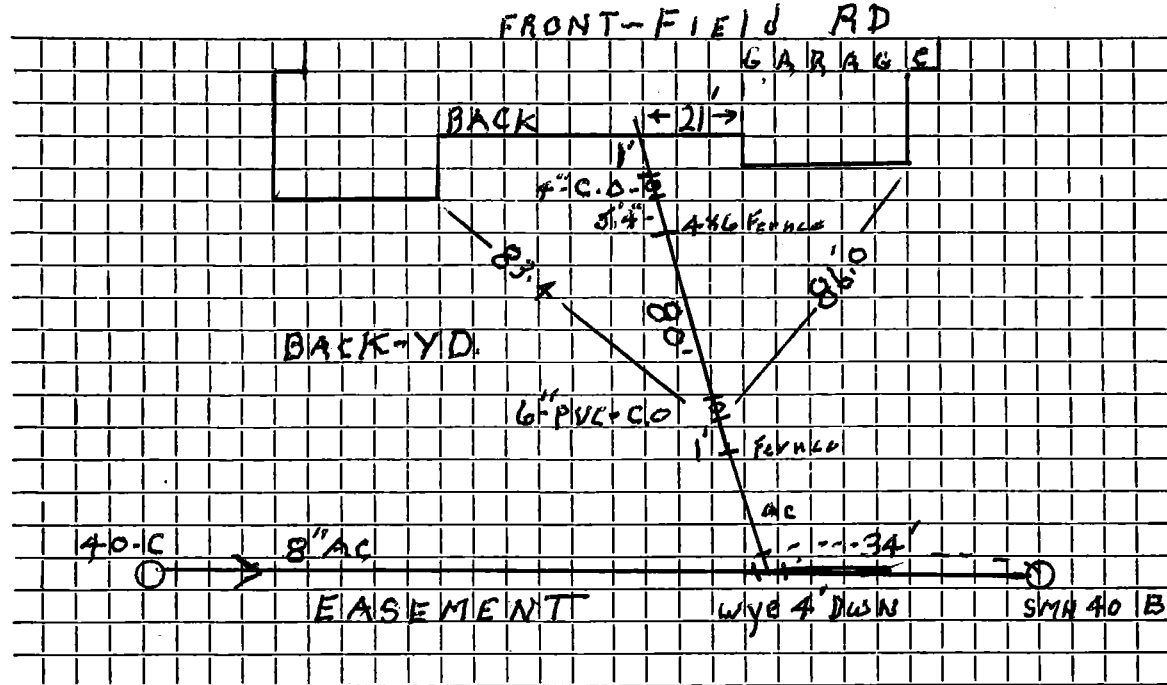

Connection made in ..... Street. Work completed 10/15/10 J. McI-.....

Remarks: Sewer gas out back to easement.....

.....

.....