

Name DeVries Const. Co., Inc.

Service No.

Address 15 Fiske Road

Location

Kind of Pipe

Size

Size of Main

Repair—Renewal—New Service Installed by developer

Location

Date	Material	Amount	Total	Date	Amount
------	----------	--------	-------	------	--------

6/7/55

Labor

TOWN OF LEXINGTON—DEPT. OF PUBLIC WORKS
SEWER DIVISION

DATE.....

NO.....


The undersigned applies for the construction of a particular sewer connecting No.....
Street and hereby agrees to comply with the Rules and Regulations governing the construction and use of Particular
Sewers, as now or at any future time established by the Board of Selectmen.

Am't of estimate \$.....

Am't Paid \$.....

..... Owner

Sketch of Service Here

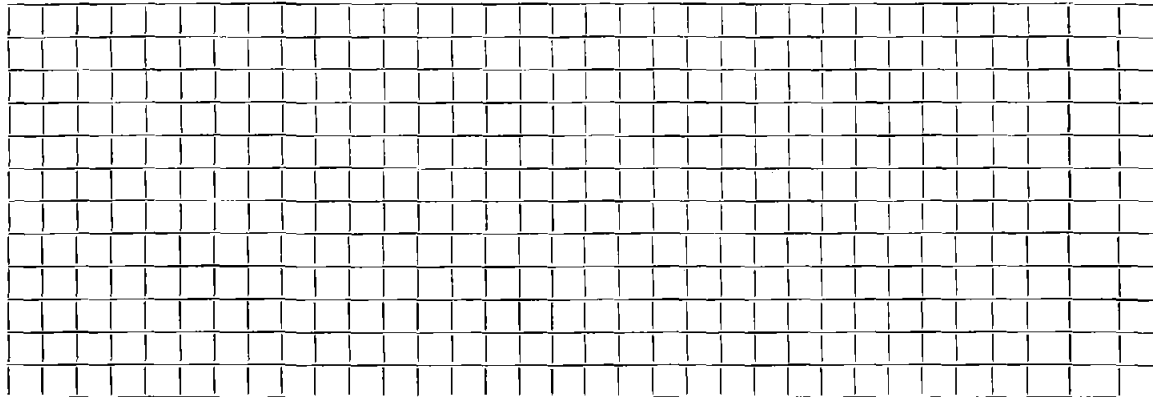

Connection made in..... Street.

Work completed..... 19..

Remarks: