

Name

Service No. 2482

Address 21 Fiske RD

LOT 44

Location

Kind of Pipe PVC

Size

Size of Main

Repair—Renewal—New Service J McLaughlin

Location

Date	Material	Amount		Total		Date		Amount
------	----------	--------	--	-------	--	------	--	--------

7/9/07	70' 4" PVC s.c. 40							
	88' 6" PVC							
	2 6"-45° bends							
	1 4X6" Ferroco							
	1 6"-ACXL" PVC Ferroco							


EXIST.-	ST. A.C. Pipe							
---------	---------------	--	--	--	--	--	--	--

DATE _____

TOWN OF LEXINGTON — BOARD OF PUBLIC WORKS

SEWER DIVISION

Sketch of Service Here

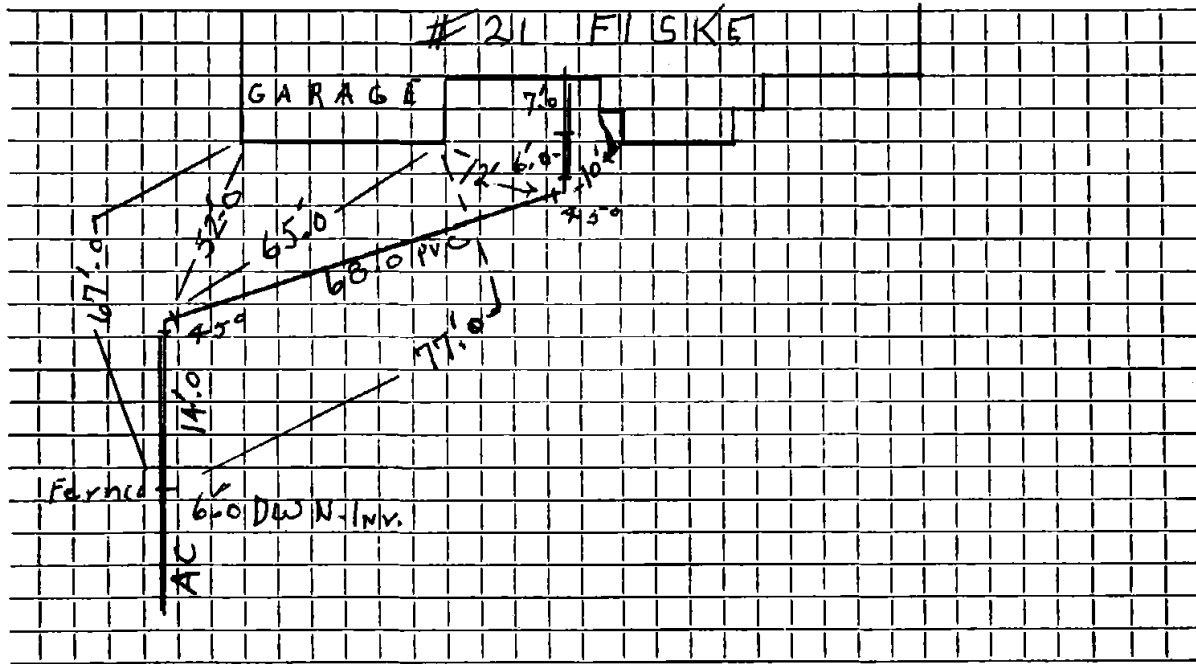

Connection made in Street.

Work completed 7/9/07 J. McLaughlin.....

Remarks:
.....
.....