

Name *Astrid Kazanjian*

Service No.

Address *6 Fiske Road*

Location

Kind of Pipe

Size

Size of Main

Repair—~~Renewal~~—~~New Service~~ *Redmond #3912*

Location

Date	Material	Amount	Total	Date	Amount
5/31/55	<i>Installed By Contractor</i>				
10/30/84	63' 6" PVC				
	1 6' x 4" Donut				
					OUTSIDE Work Order #996
				10/30/84	17' 6" PVC
					1 6" PVC Coupling
					1 8" x 8" x 6" PVC Tee
					4' 8" PVC
					2 8" Clay to PVC Coupling
					8 Yards Gravel
					2 Tons Cold Patch
					Patch 16' x 10'


DATE _____

TOWN OF LEXINGTON — BOARD OF PUBLIC WORKS

SEWER DIVISION

Sketch of Service Here

6

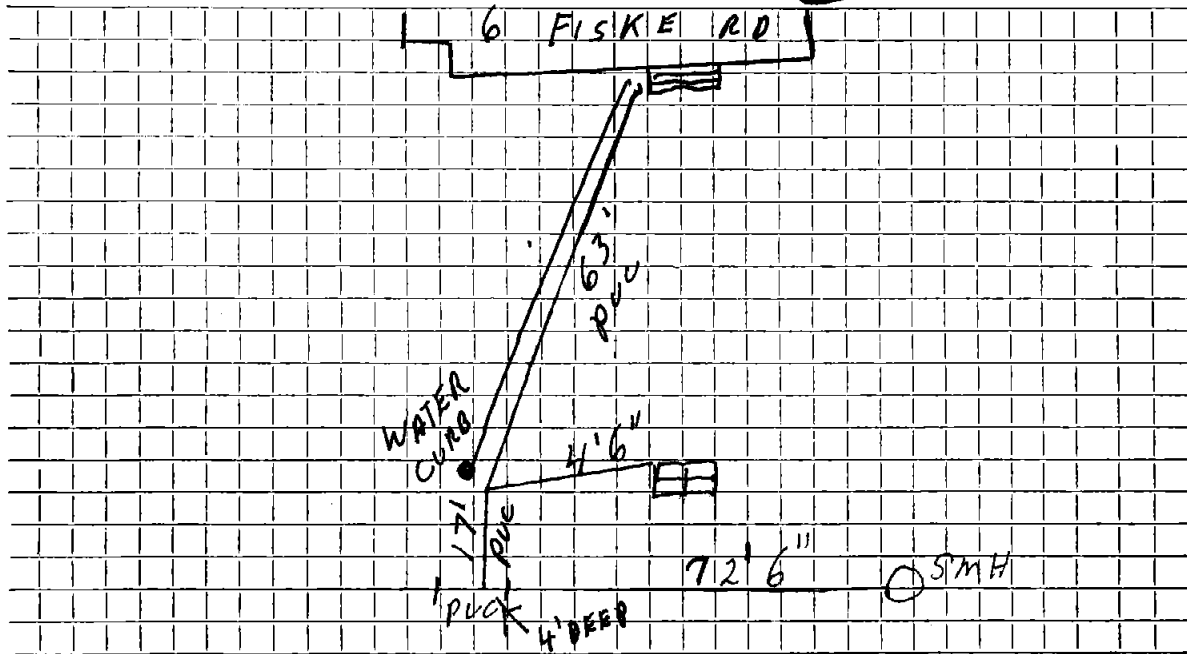

Connection made in Street. Work completed

Remarks:

.....

.....