

Name

Service No.

Address 44 FLETCHER

Location

Kind of Pipe

Size

Size of Main

Repair—Renewal—New Service

Location

Date

Material

Amount

Total

Date

Amount


6" SDR

6" CLEAN OUT

6" x 6' FRAMES

TOWN OF LEXINGTON — BOARD OF PUBLIC WORKS
SEWER DIVISION

Sketch of Service Here

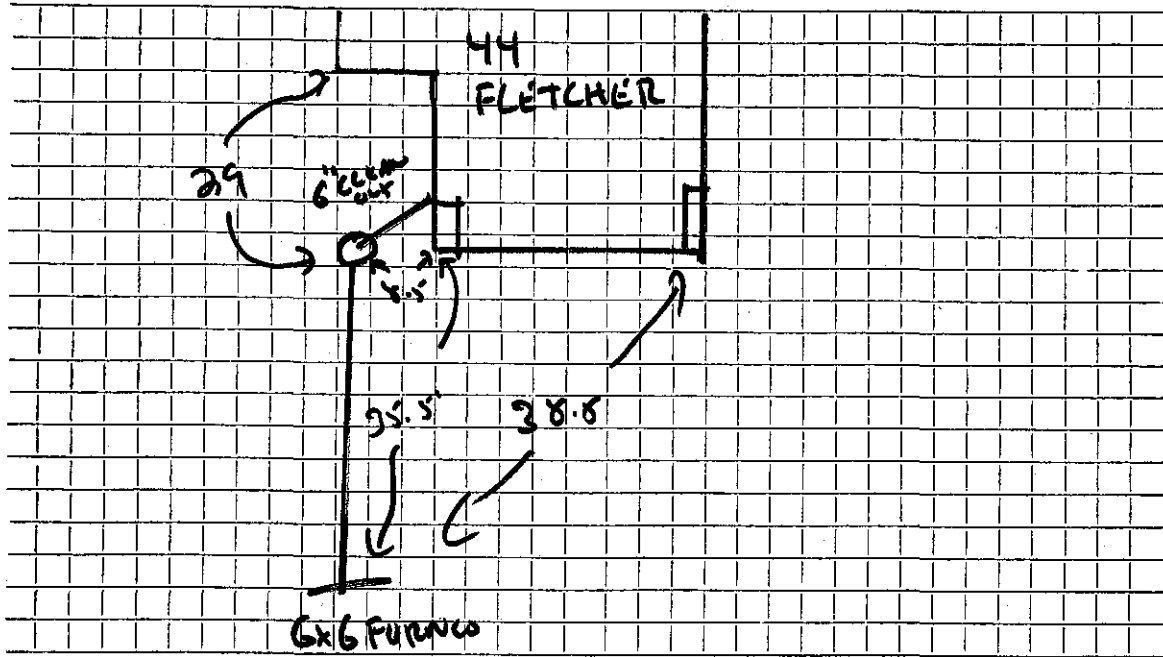

Connection made in Fletcher Street. Work completed

Remarks:
.....
.....