

Name

Service No.

Address 11 & 13 Fletcher Avenue

Location

Kind of Pipe

Size

Size of Main

~~Repair~~ - Renewal - ~~Water~~ ~~Service~~ Eagle #


Location

| Date | Material | Amount | Total | Date | Amount |
|---------|----------------------|--------|-------|----------|---------------------------|
| 12-5-79 | 23' 6" Transite pipe | | | | |
| 1 | 1' x 6" Nipple | | | | |
| 1 | 10' x 6" A.C. Pipe | | | 9-9-77 | |
| 2 | 5' x 6" A.C. Nipple | | | 2 | 36" x 6" Transite Nipples |
| 1 | 2' x 6" A.C. Nipple | | | 1 | 6" Coupling |
| | | | | | |
| | | | | | |
| | | | | 11-19-79 | Roots 20 ft out |
| | | | | | |
| | | | | | |
DATE _____

TOWN OF LEXINGTON — BOARD OF PUBLIC WORKS
SEWER DIVISION

Sketch of Service Here **11+13**

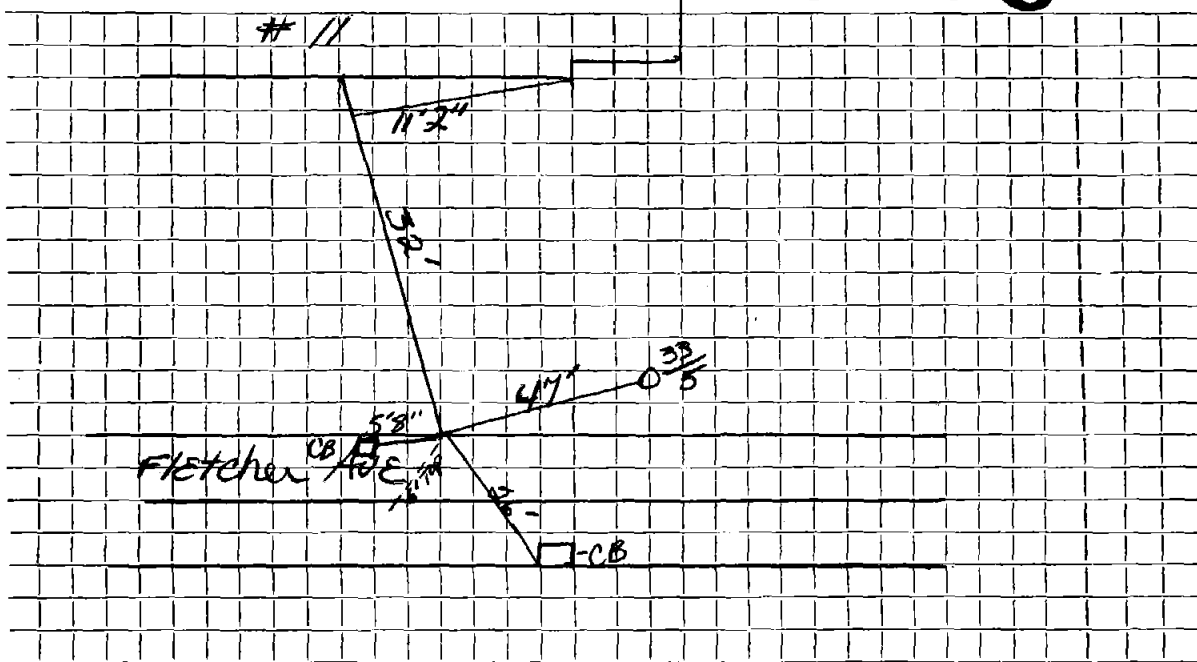

Connection made in Street. Work completed

Remarks: *1932 on other card*

.....
.....