


DATE _____

TOWN OF LEXINGTON — BOARD OF PUBLIC WORKS

SEWER DIVISION

Sketch of Service Here

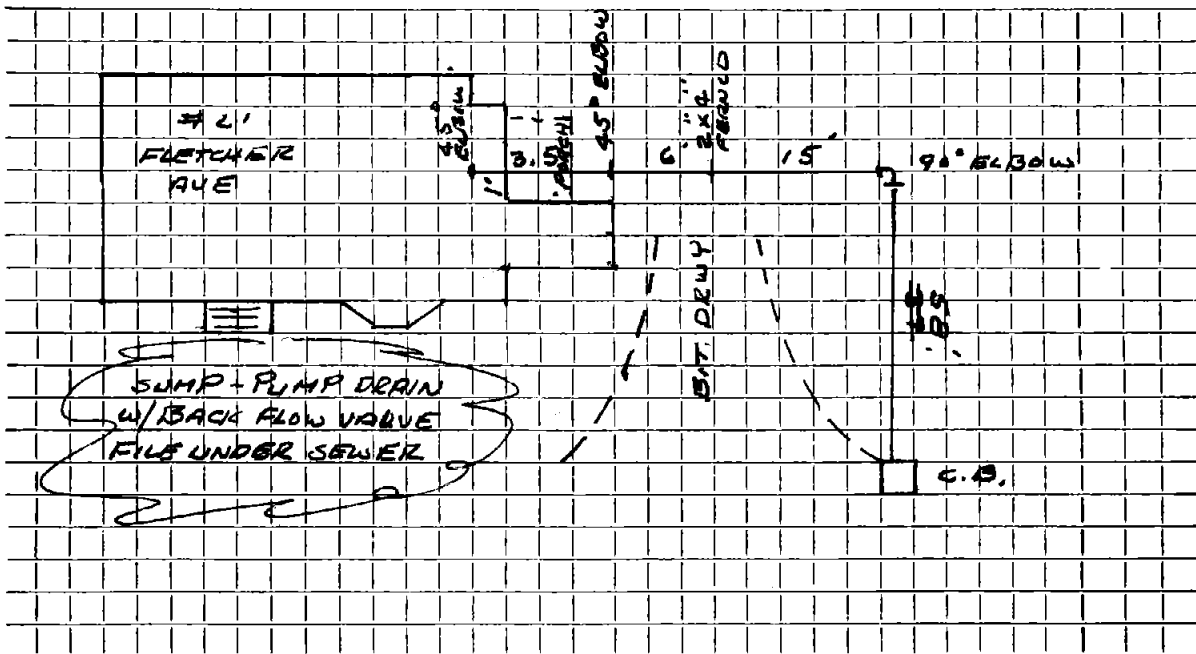

Connection made in FLETCHER AVE. Street. Work completed

Remarks: SUMP-PUMP

.....
.....