


DATE _____

TOWN OF LEXINGTON — BOARD OF PUBLIC WORKS

SEWER DIVISION

Sketch of Service Here

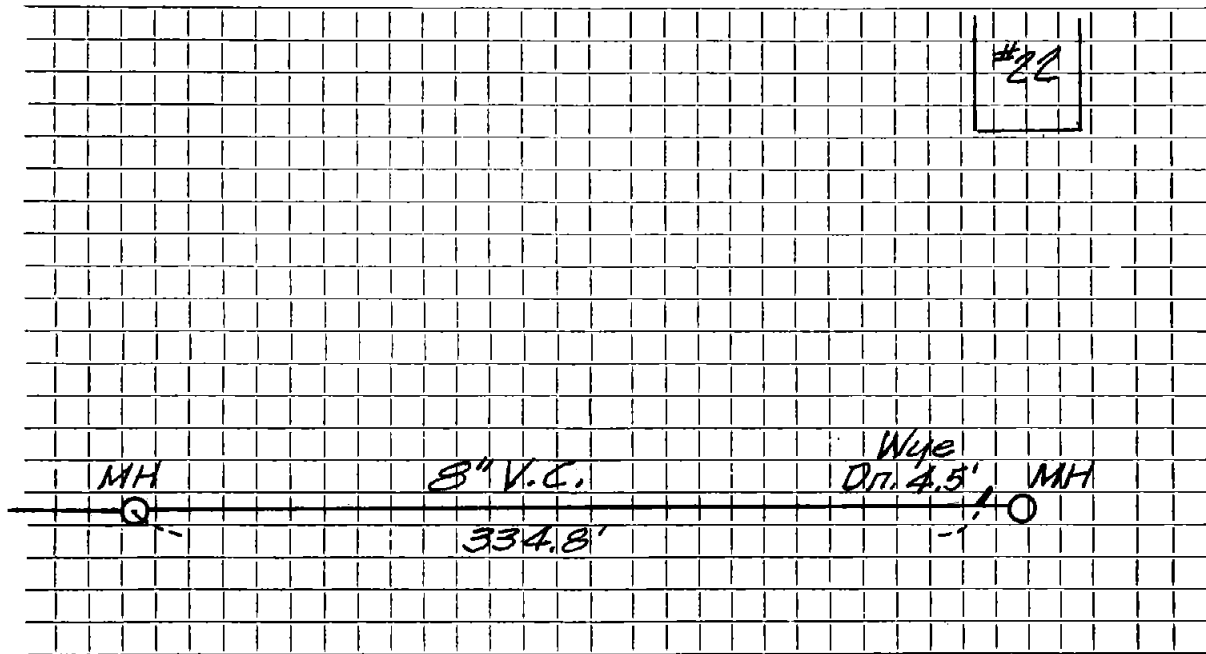

Connection made in Street. Work completed

Remarks: 3.12.99 Dye test done DYE showed up at
Sheridan + Grant St Sewer seems to go out back