

Name Manfred Friedman

Service No. 71

Address 25 Fletcher Avenue

Location

Kind of Pipe

Size

Size of Main

~~REPAIR~~ ~~RENEWAL~~ — New Service Eagle 3474

Location


DEC 3 1979

Date	Material	Amount	Total	Date	Amount
10-29-79	Labor	132.15		10-17-79	290.00
	10% O.H.	13.22	145.37	12-14-79	<del>242</del>
10'	6" Transite pipe @1.91		19.10		297.42
1	5' Nipple		12.25		
1	2' Nipple		7.60		
1	3' Nipple		12.64		
1	6" x 45° Bend		5.69		
1	End Cap		2.95		
2	hrs. Trucking @3.00		6.00		
3	hrs. Backhoe @6.50		19.50		
1	hr. Compressor		5.00		
	Hot Top 4' x 23'		61.32		
			297.42		
11-6-79	58' 6" Transite pipe				
	10' 4" Cast Iron pipe				

DATE \_\_\_\_\_

TOWN OF LEXINGTON — BOARD OF PUBLIC WORKS  
SEWER DIVISION

Sketch of Service Here

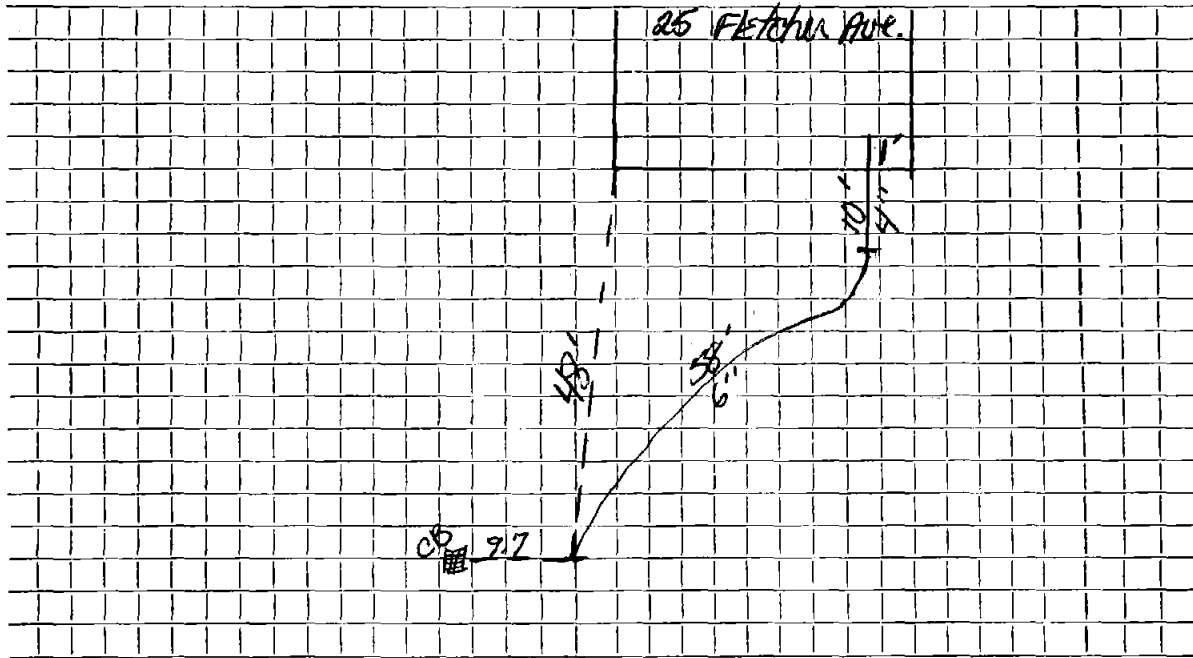

Connection made in ..... Street. Work completed .....

Remarks: .....  
.....  
.....



TOWN OF LEXINGTON—DEPT. OF PUBLIC WORKS  
SEWER DIVISION

DATE .....

NO. ....


The undersigned applies for the construction of a particular sewer connecting No. ....  
Street and hereby agrees to comply with the Rules and Regulations governing the construction and use of Particular  
Sewers, as now or at any future time established by the Board of Selectmen.

Am't of estimate \$.....

Am't Paid \$.....

..... Owner

Sketch of Service Here

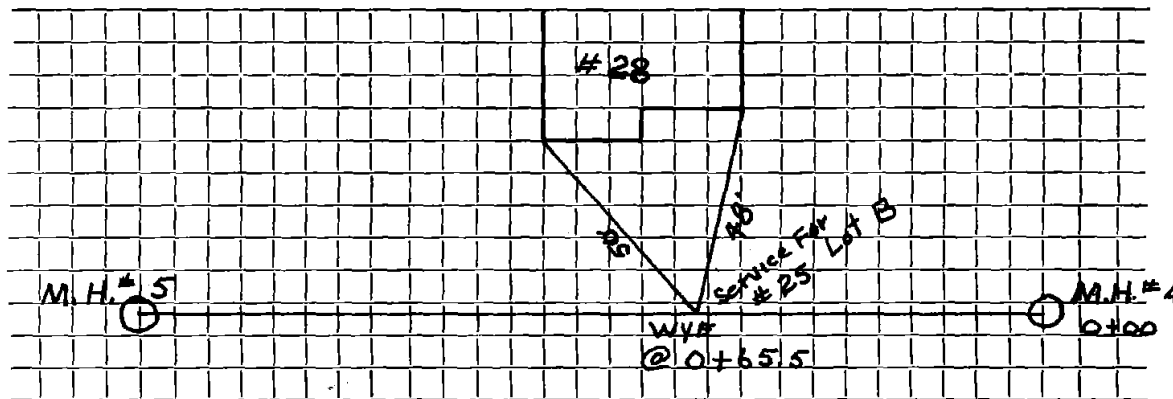

Connection made in ..... Street.

Work completed ..... 19..

Remarks: