

Name Willis R. Anderson

Service No. 124

Address 26 Fletcher Avenue

Location

Kind of Pipe

Size

Size of Main

~~Repair~~ ~~Renewal~~ - New Service

com. 8-15-55

Location

Date	Material	Amount	Total	Date	Amount
6/23/55	Labor	50 17		6-16-55	Deposited 150 00
	10% Overhead	5 02	55 19	8-15-55	Refunded (50 59)
	44'-6" Sewer Pipe @ .32		14 08		NON CHARGE 99 41
	Joint Compound		2 64	6/23/55	Labor 94 39
	4 hrs. Town Shovel @ 5.00		20 00	66'-8" Sewer Pipe @ .658	43 43
	2 hrs. Trucking @ .75		1 50	1-8x6 Tee	2 40
	Patching 6x3		6 00	Joint Compound	3 96
			99 41	4 hrs. Town Shovel @ 5.00	20 00
				2 hrs. Hough Loader @ 3.00	6 00
6/6/53	new House being built			3 hrs. Trucking @ .75	2 25
	will replace sewer to			Patching 66x3	66 00
	property line				238 43
	Labor			8/31/71	Sludge
	line on street thru <u>rocks</u>				
	RP				

TOWN OF LEXINGTON—DEPT. OF PUBLIC WORKS

SEWER DIVISION

DATE

NO.


The undersigned applies for the construction of a particular sewer connecting No.
Street and hereby agrees to comply with the Rules and Regulations governing the construction and use of Particular
Sewers, as now or at any future time established by the Board of Selectmen.

Am't of estimate \$.

Am't Paid \$.

..... Owner

Sketch of Service Here

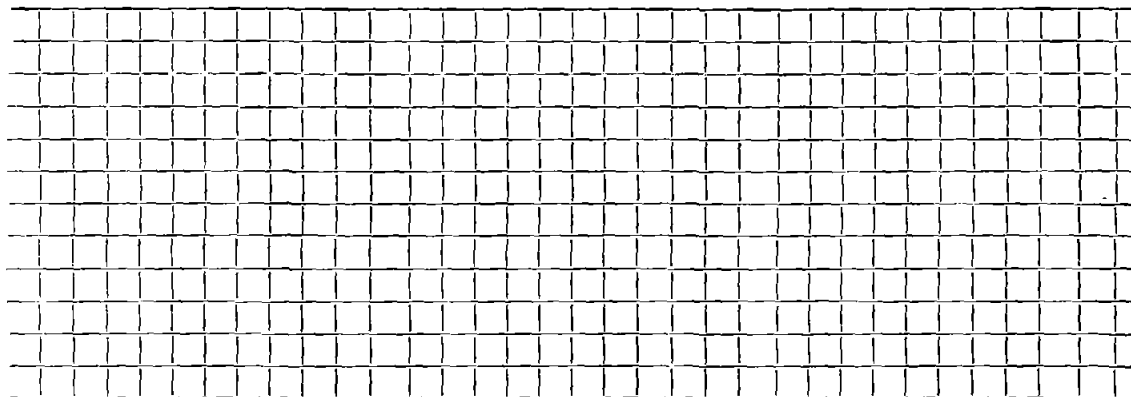

Connection made in Street.

Work completed 19..

Remarks: