

Name John D. MacNeil

Service No. 45

Address 28 Fletcher Avenue

Location

Comm. 7/22/57

Kind of Pipe

Size

Size of Main

Repair ~~XXXXXX~~ Renewal — New Service

Location

Date	Material	Amount	Total	Date	Amount
4/29/57	Labor	76 57		4-15-57	Deposit # 150 00
	10% overhead	7 66	84 23	8-2-57	Paid by refund
	50' - 6" Transite Pipe @ .7020		35 10		on Tr. H.C # 68 9 58
	1 - 6" Elbow		2 79		159 68
	3 hrs. Town Shovel @ 6.50		19 50	8-14-57	Paid 3 54
	2 hrs. Trucking @ .75		1 50		# 163 12
	20x3 Patch		20 00		
			163.12		

Labor

Bill sent 7/24/57

TOWN OF LEXINGTON—DEPT. OF PUBLIC WORKS
SEWER DIVISION

DATE

NO.


The undersigned applies for the construction of a particular sewer connecting No. Street and hereby agrees to comply with the Rules and Regulations governing the construction and use of Particular Sewers, as now or at any future time established by the Board of Selectmen.

Am't of estimate \$.

Am't Paid \$.

..... Owner

Sketch of Service Here **28**

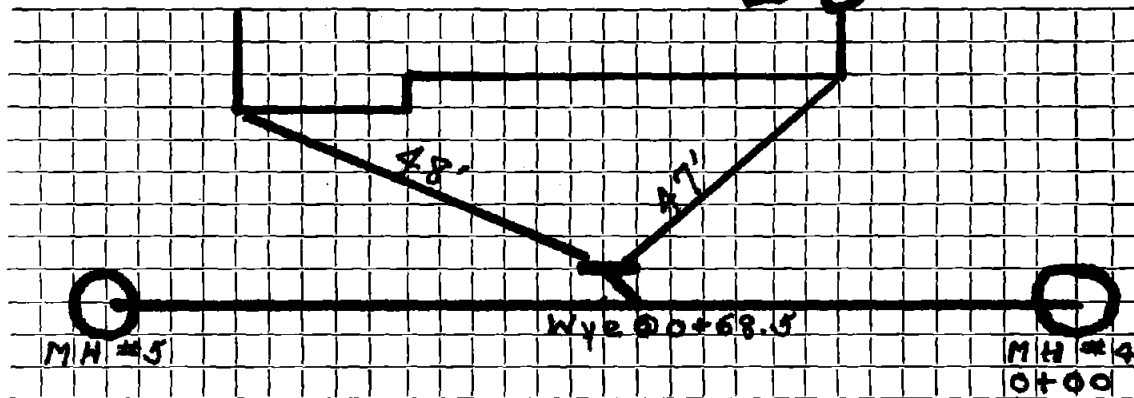

Connection made in Street.

Work completed 19..

Remarks: