

Name John L. Pichette

Service No. 127

Address 30 Fletcher Avenue

Location

Comm. 11-18-57

Kind of Pipe

Size

Size of Main

~~Repair~~ ~~Renewal~~ ~~New Service~~

Location

Date	Material	Amount	Total	Date	Amount
8/21/57	Labor	18 26		8-19-57	Deposit \$150 00
8/22/57	"	73 06		12-4-57	Paid 7 63
		91 32			\$157 63
	10% overhead	9.13	100 45		
	49' - 6" Transite pipe @ .70		34 30		
	1 - 6" Clay elbow		1 88		
	3 hrs. Town Shovel @ 6.50		19 50		
	2 hrs. Trucking @ .75		1 50		
			157 63		
	Labor			5-30-81	Root 41' out
				5-31-81	Roots at Main
					150' out

TOWN OF LEXINGTON—DEPT. OF PUBLIC WORKS
SEWER DIVISION

DATE.....


NO.

The undersigned applies for the construction of a particular sewer connecting No.....
Street and hereby agrees to comply with the Rules and Regulations governing the construction and use of Particular
Sewers, as now or at any future time established by the Board of Selectmen.

Am't of estimate \$.

Am't Paid \$.

..... Owner

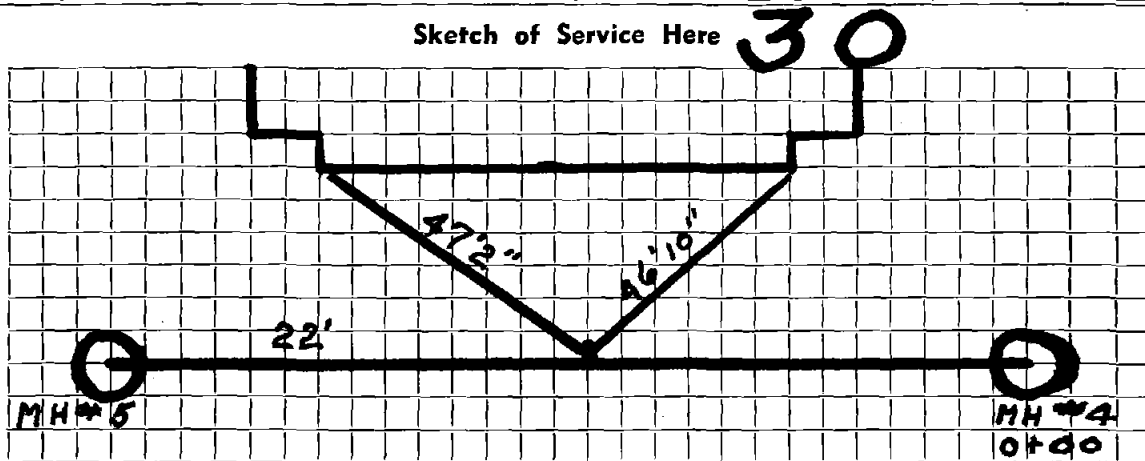

Connection made in..... Street.

Work completed..... 19..

Remarks: 8" Main 8' Deep
90° Elbow 6' Deep