

Name

Service No.

Address

34 Fletcher Ave

Location

Kind of Pipe

Size

Size of Main

Repair—Renewal—New Service

Location

Date

Material

Amount

Total

Date

Amount

7-17-01

Inside Renewed

23'-6" PVC

3'-4" CI

6x4 CI to PVC FERNCO

6x6 AC to PVC FERNCO

9-20-73

10'-6" AC

1- 11 1/4° SWEEP

1- 30° Elbow


2'-5'x6'- NIPPLES

DATE _____

TOWN OF LEXINGTON — BOARD OF PUBLIC WORKS

SEWER DIVISION

Sketch of Service Here

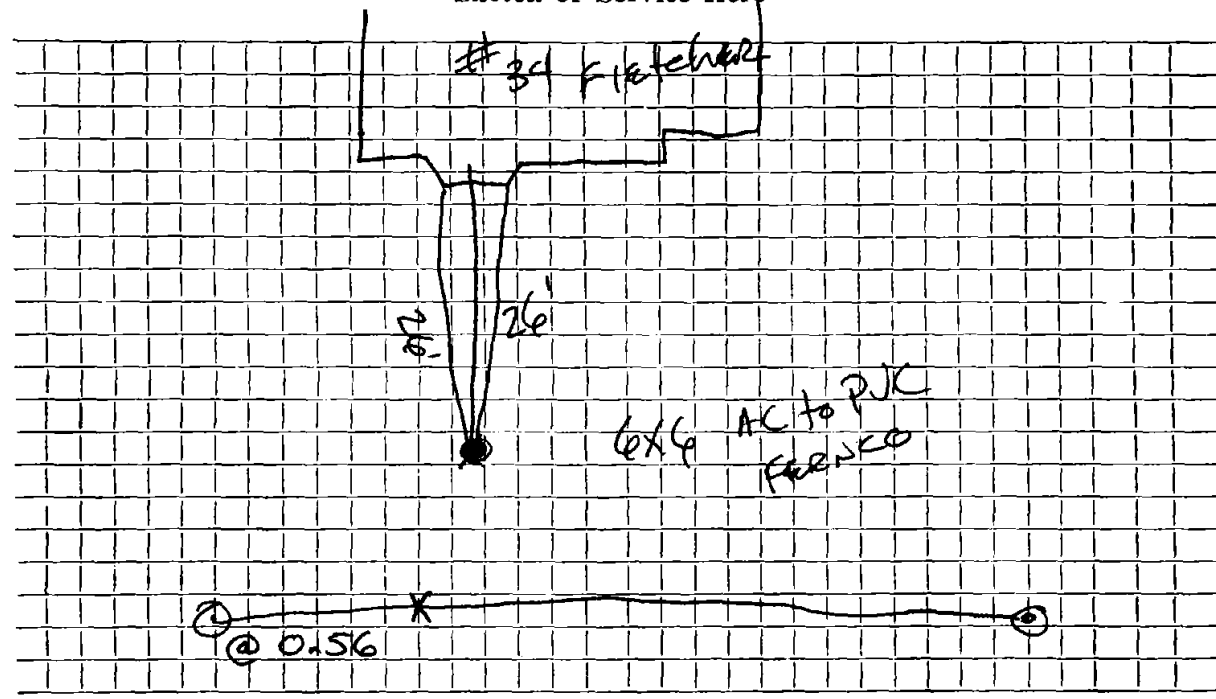

Connection made in Street. Work completed

Remarks:
.....
.....