

Name Robert Fuller

Service No. 182

Address #36 Fletcher Ave.

Location

Kind of Pipe

Size

Size of Main

~~Repair~~ ~~Renewal~~ New Service

Location *Com. 11-14*

Date	Material	Amount	Total	Date	Amount
10-4-60	Labor	66.73		<i>7-20-60</i>	<i>200.00</i>
10-5-60	"	20.53	87.26	<i>11-14-60</i>	<i>22.61</i>
	10% O.H.	8.73	95.99		<i>177.99</i>
	45' 6" Transite pipe @.78		35.10		
	1 6" Transite Elbow 90°		5.40		
	10 x 3 Patch		10.00		
	5 hrs. Pippin Shovel @4.50		22.50		
	3 hrs. Trucking @3.00		9.00		
			177.99		
	<b>Labor</b>				

TOWN OF LEXINGTON—DEPT. OF PUBLIC WORKS

SEWER DIVISION

DATE .....

NO. ....


The undersigned applies for the construction of a particular sewer connecting No. ....  
Street and hereby agrees to comply with the Rules and Regulations governing the construction and use of Particular  
Sewers, as now or at any future time established by the Board of Selectmen.

Am't of estimate \$.....

Am't Paid \$.....

..... Owner

Sketch of Service Here **36**

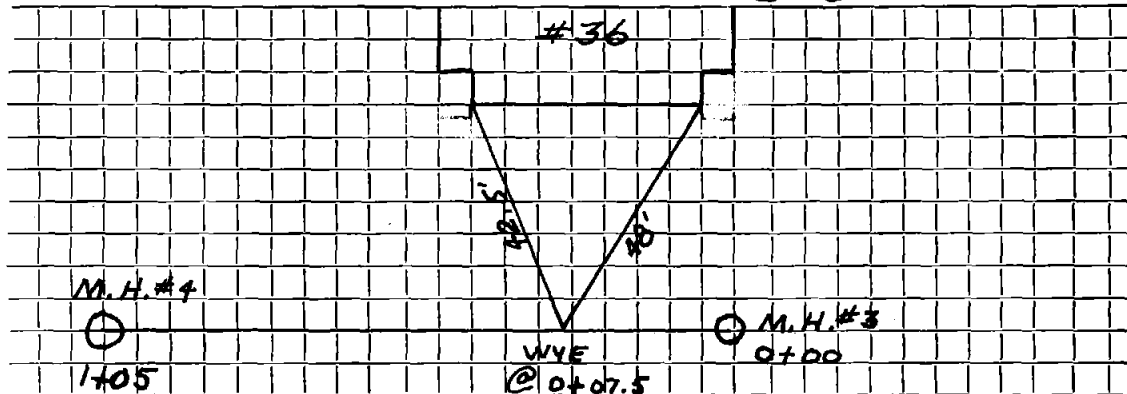

Connection made in ..... Street.

Work completed ..... 19..

Remarks: