

Name Robert Millar

Service No. 62

Address #38 Fletcher Ave.

Location

Kind of Pipe

Size

Size of Main

~~Repair~~ New Service

Location Comm 7-17-61

Date	Material	Amount	Total	Date		Amount
6-13-61	Labor	64.67		5-31-61	Deposit	200.00
6-14-61	Labor	17.51	82.18	7-17-61	Refund	31.84
	10% O.H.	8.22	90.40			168.16
	42' 6" Transite pipe @.78		32.76			
	4 Hrs. pippin Shovel @6.50		26.00		NON CHARGE	
	3 Hrs. Trucking @3.00		9.00	6-13-61	Labor	19.40
	10 x 3 Patch		10.00			
			168.16			
	Labor					

TOWN OF LEXINGTON—DEPT. OF PUBLIC WORKS
SEWER DIVISION

DATE

NO.


The undersigned applies for the construction of a particular sewer connecting No.
 Street and hereby agrees to comply with the Rules and Regulations governing the construction and use of Particular
 Sewers, as now or at any future time established by the Board of Selectmen.

Am't of estimate \$.....

Am't Paid \$.....

..... Owner

Sketch of Service Here **38**

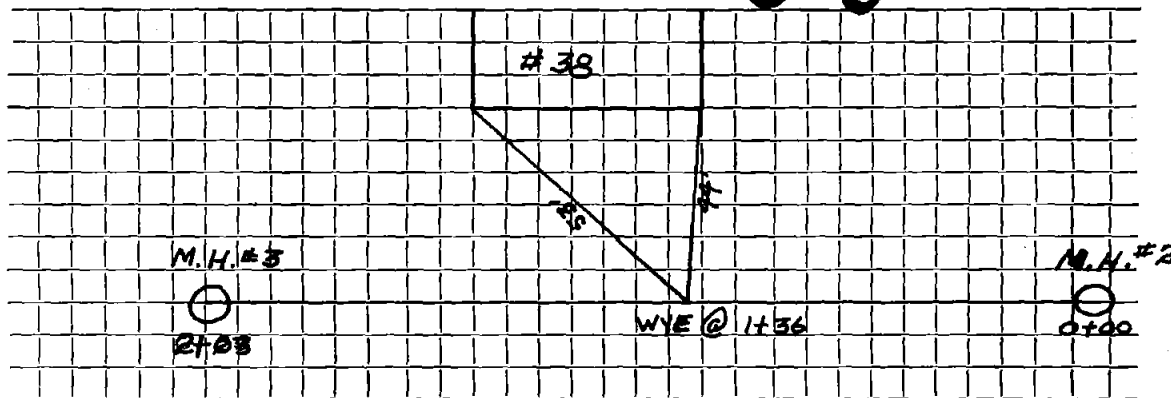

Connection made in Street.

Work completed 19..

Remarks: