

Name Jeanne Crowther

Service No. 133

Address # 40 Fletcher Ave.

Location

Kind of Pipe

Size

Size of Main

~~Transit Renewal~~ - New Service W O # 7549

Location Comm 10-29-62

Date	Material	Amount	Total	Date	Amount
8-27-62	Labor 37.32			8-15-62	225.00
8-28-62	" 102.84	140.16		11-9-62	50.07
	10% O.H.	14.02	154.18		275.07
	59' 6" Transite pipe @.82		48.38		
	1 90° 6" Transite Elbow		4.09		
	2 11¼° Transite bends @4.09		8.18		
	2 Duplex Adapter @1.62		3.24		
	4 hrs. Town Shovel @6.50		26.00		
	2 hrs. Trucking @3.00		6.00		
	1 hr. Loader @3.00		3.00		
	19 x 3 Patch		19.00		
	3 x 3 Labor Sidewalk Patch		3.00		
			275.07		

TOWN OF LEXINGTON—DEPT. OF PUBLIC WORKS

SEWER DIVISION

DATE

NO.


The undersigned applies for the construction of a particular sewer connecting No.
Street and hereby agrees to comply with the Rules and Regulations governing the construction and use of Particular
Sewers, as now or at any future time established by the Board of Selectmen.

Am't of estimate \$.....

Am't Paid \$.....

..... Owner

Sketch of Service Here **40**

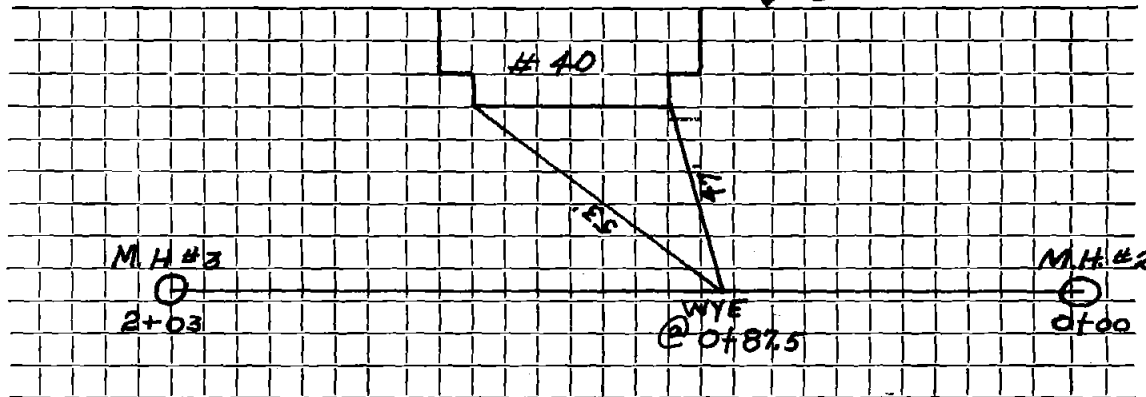

Connection made in Street.

Work completed 19..

Remarks: