

Name Eben H. Murray

Service No. 60

Address 42 Fletcher Avenue

Location

Comm. 9/30/57

Kind of Pipe

Size

Size of Main

~~Repair~~ ~~Renewal~~ ~~New Service~~

Location

Date	Material	Amount	Total	Date		Amount
5/23/57	Labor	69 07		5-9-57	<i>Deposit</i>	\$ 200 00
	10% overhead	6 91	75 98	9-30-57		<i>Refund</i>
	48' - 6" Transite Pipe @ .4228		33.70			\$ 145 06
	1 - 6" Elbow		1 88			
	2 hrs. Town Shovel @ 6.50		13 00			
	2 hrs. Trucking @ .75		1 50			
	1 hr. Hough Loader		3 00			
	13x3 Patch		13 00			
			145 06			
	<b>Labor</b>					

**TOWN OF LEXINGTON—DEPT. OF PUBLIC WORKS**  
**SEWER DIVISION**

DATE.....

NO. ....


The undersigned applies for the construction of a particular sewer connecting No.....  
 Street and hereby agrees to comply with the Rules and Regulations governing the construction and use of Particular  
 Sewers, as now or at any future time established by the Board of Selectmen.

Am't of estimate \$.....

Am't Paid \$.....

..... Owner

Sketch of Service Here **42**

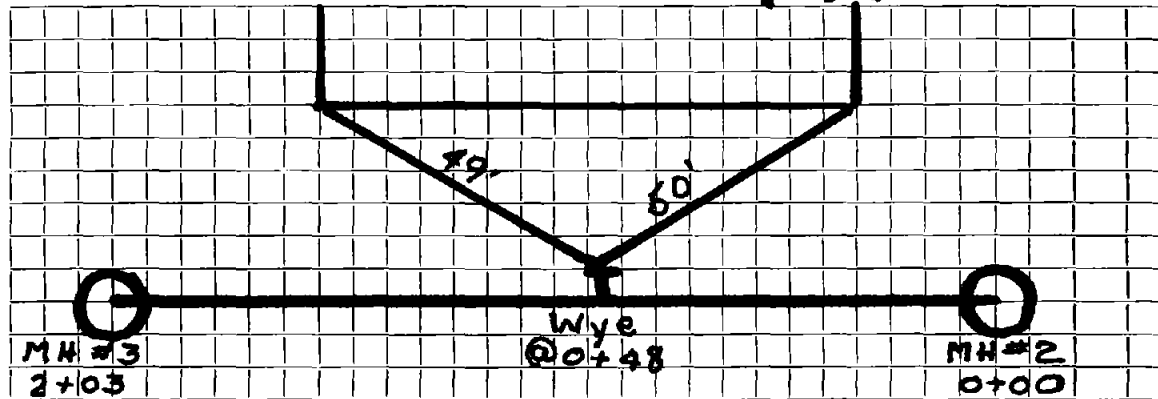

Connection made in..... Street.

Work completed..... 19..

Remarks: