

Name James H. Lewis Tr.

Service No. 53

Address # 46 Fletcher Ave.

Location

Kind of Pipe

Size

Size of Main

~~Repair~~ ~~Renewal~~ - New Service 100 # 2980

Location Comm 8-26-63

Date	Material	Amount	Total	Date	Amount
7-1-63	Labor 97.08			5-22-63	250.00
7-2-63	" 31.05	128.13		8-26-63	10.23
	10% O.H.	12.81	140.94		239.77
	48' 6" Transite pipe @.88		42.24		
	1 90° Transite Elbow		4.09		
	5 yds. Loam @3.00		15.00		
	12 x 3 Patch		12.00		
	3 hrs. Town Shovel @6.50		19.50		
	2 hrs. Trucking @3.00		6.00		
			239.77		
	Labor				

TOWN OF LEXINGTON—DEPT. OF PUBLIC WORKS
SEWER DIVISION

DATE NO.


The undersigned applies for the construction of a particular sewer connecting No. Street and hereby agrees to comply with the Rules and Regulations governing the construction and use of Particular Sewers, as now or at any future time established by the Board of Selectmen.

Am't of estimate \$.....

Am't Paid \$.....

..... Owner

Sketch of Service Here **46**

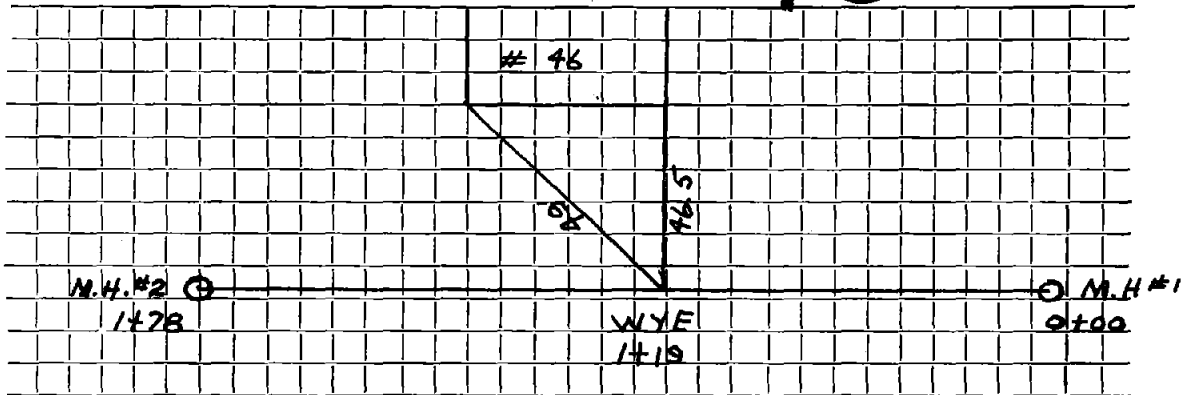

Connection made in Street.

Work completed 19..

Remarks:

