

Name Ernest Ganshirt

Service No. 38

Address 48 Fletcher Avenue

Location

Comm. 7/22/57

Kind of Pipe

Size

Size of Main

Repair—Renewal—New Service

Location

Date	Material	Amount	Total	Date	Amount
5/2/57	Labor	70 66		4-8-57	Deposit \$ 200 00
	10% overhead	7 07	77 73	7-22-57	Refund 41 11
	52' - 6" Transite Pipe @ .7020		36 50		\$ 158 89
	2' - 6" V. C. Pipe @ .435		87		
	1 - 6" Elbow		2 79	10-9-03	Renewed From Property Line To Main - 17' PVC
	3 hrs. Town Shovel @ 6.50		19 50		
	2 hrs. Trucking @ .75		1 50		
	20x3 patch		20 00		
			158 89		
				9/3/93	Roots Metro sewer 60' out Respond + measure (M)
				7-10-95	PAPERS - some roots 52' out. TOWN problem
	Labor				Respond
				10-7-98	Roots 50'-52' out

TOWN OF LEXINGTON—DEPT. OF PUBLIC WORKS  
SEWER DIVISION

DATE .....


NO. ....

The undersigned applies for the construction of a particular sewer connecting No. ....  
Street and hereby agrees to comply with the Rules and Regulations governing the construction and use of Particular  
Sewers, as now or at any future time established by the Board of Selectmen.

Am't of estimate \$.....

Am't Paid \$.....

..... Owner

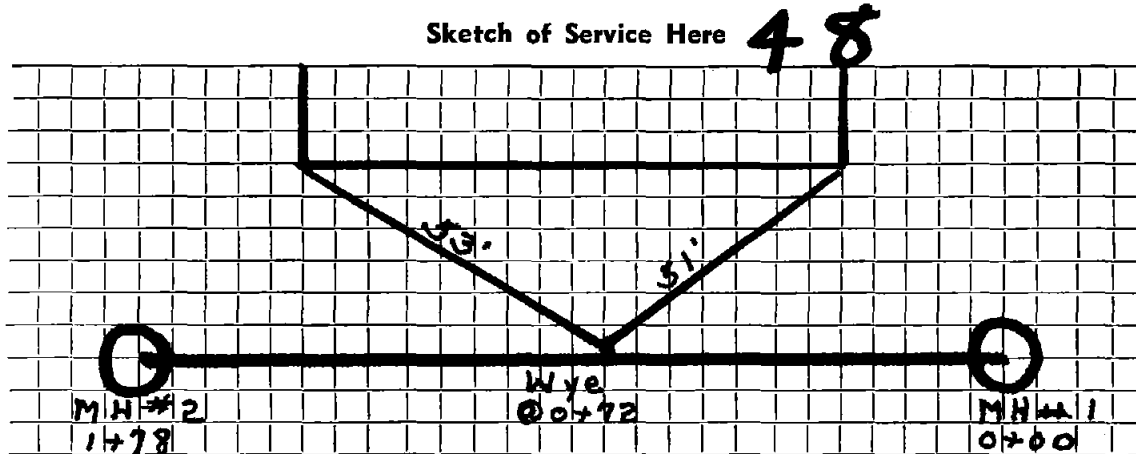

Connection made in ..... Street.

Work completed ..... 19..

Remarks: