




DATE \_\_\_\_\_

TOWN OF LEXINGTON — BOARD OF PUBLIC WORKS

SEWER DIVISION

Sketch of Service Here **49**

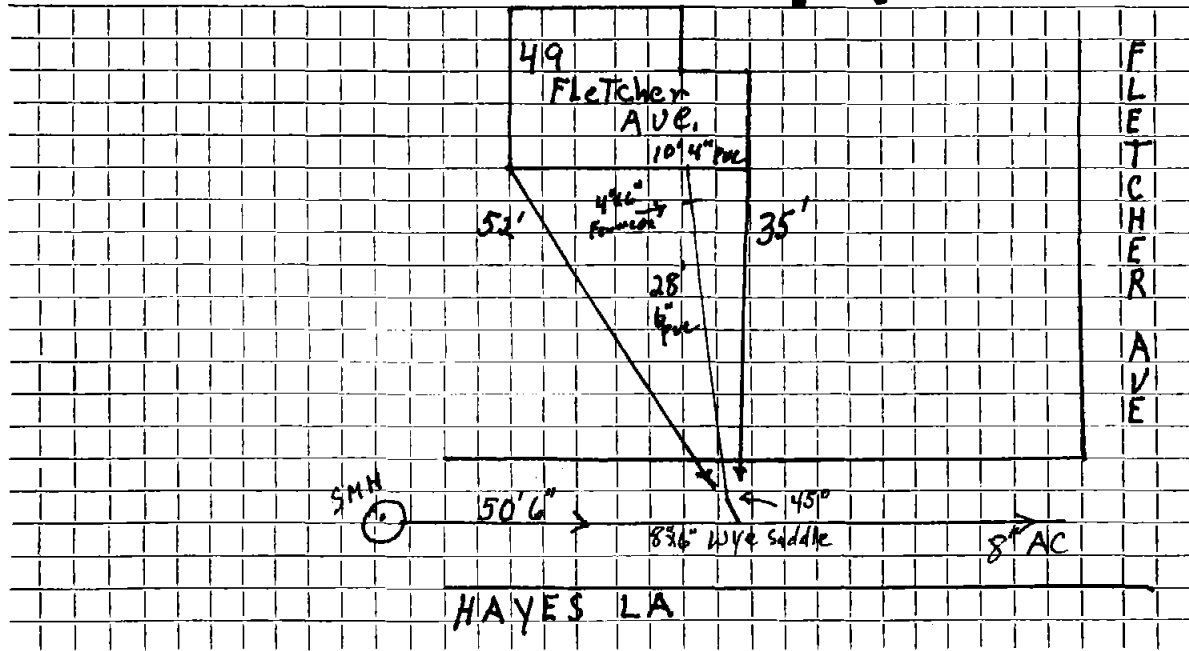

Connection made in Hayes La. Street. Work completed .....

Remarks: .....

.....

.....