




DATE NOV 2, 1982

TOWN OF LEXINGTON — BOARD OF PUBLIC WORKS  
SEWER DIVISION

Sketch of Service Here

5

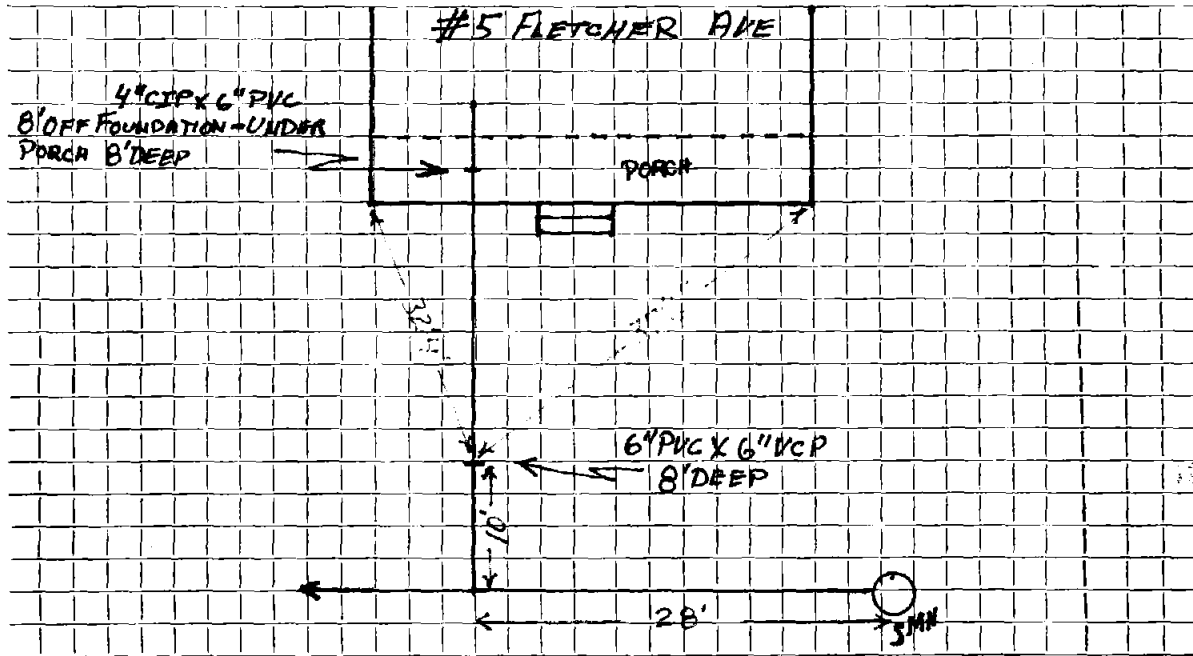

Connection made in FLETCHER AVE Street. Work completed .....

Remarks: .....