

Name

Service No.

Address FLETCHER AVE - E.E. CAUZI CONST CO

(TRAIKERS)

Location

Kind of Pipe

Size

Size of Main

~~Repair - Renewal~~ **New Service** Baptiste #4550

Location

Date		Material	Amount		Total		Date		Amount	
10/16/84	80'	x 6" PVC								
	1	6" Wye								
	1	6" Tee								
	1	6" 45° Elbow								
							10/16/84	26'	x 6" PVC	
								1	8" x 6" Saddle	
								1	90° x 6" Elbow	


OUTSIDE

DATE OCTOBER 1984

TOWN OF LEXINGTON — BOARD OF PUBLIC WORKS

SEWER DIVISION

Sketch of Service Here

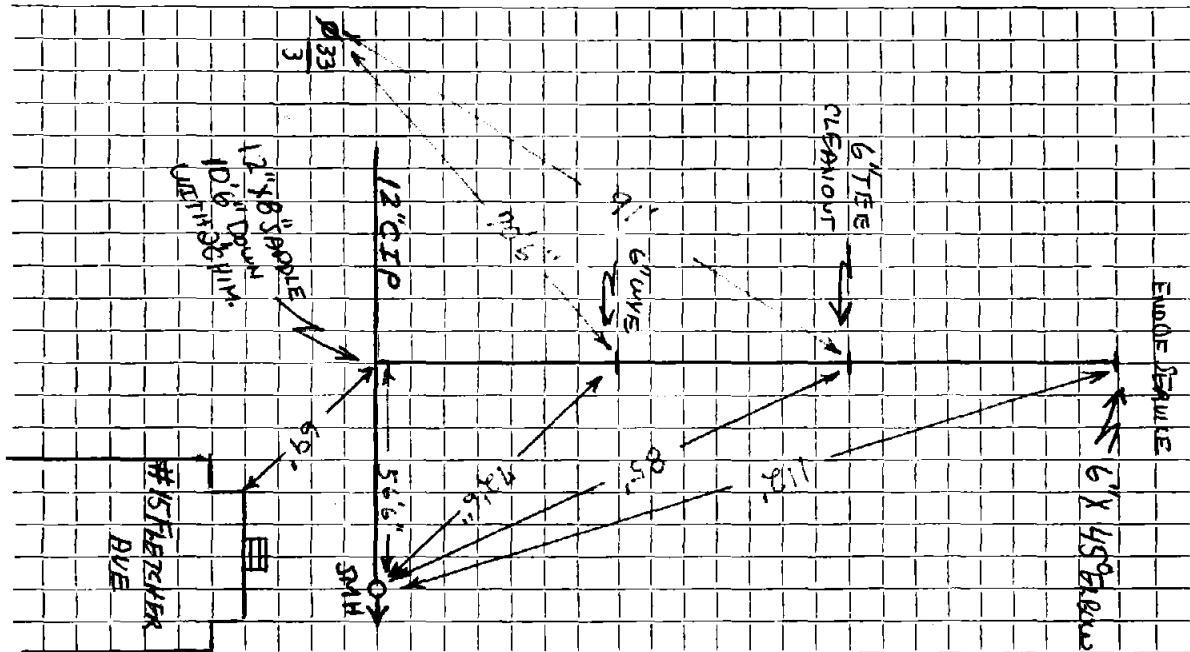

Connection made in FLETCHER AVE Street. Work completed OCTOBER 18, 1984

Remarks: SERVICE FOR TWO CONSTRUCTION TRAILERS

.....
.....