


DATE 1/21/2020

TOWN OF LEXINGTON — BOARD OF PUBLIC WORKS
SEWER DIVISION

Sketch of Service Here

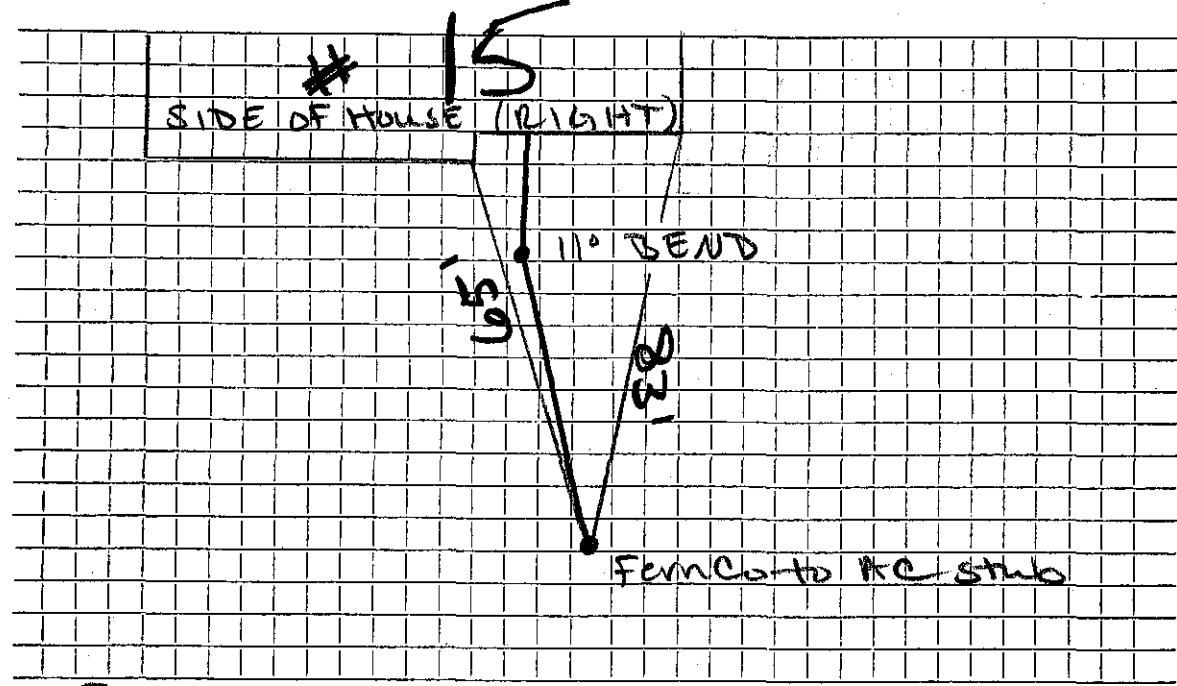

Connection made in ... Flintlock Rd ... Street. Work completed

Remarks: ... 78' of SDR 35 ...