




DATE 1/19/21

TOWN OF LEXINGTON — BOARD OF PUBLIC WORKS  
SEWER DIVISION

Sketch of Service Here

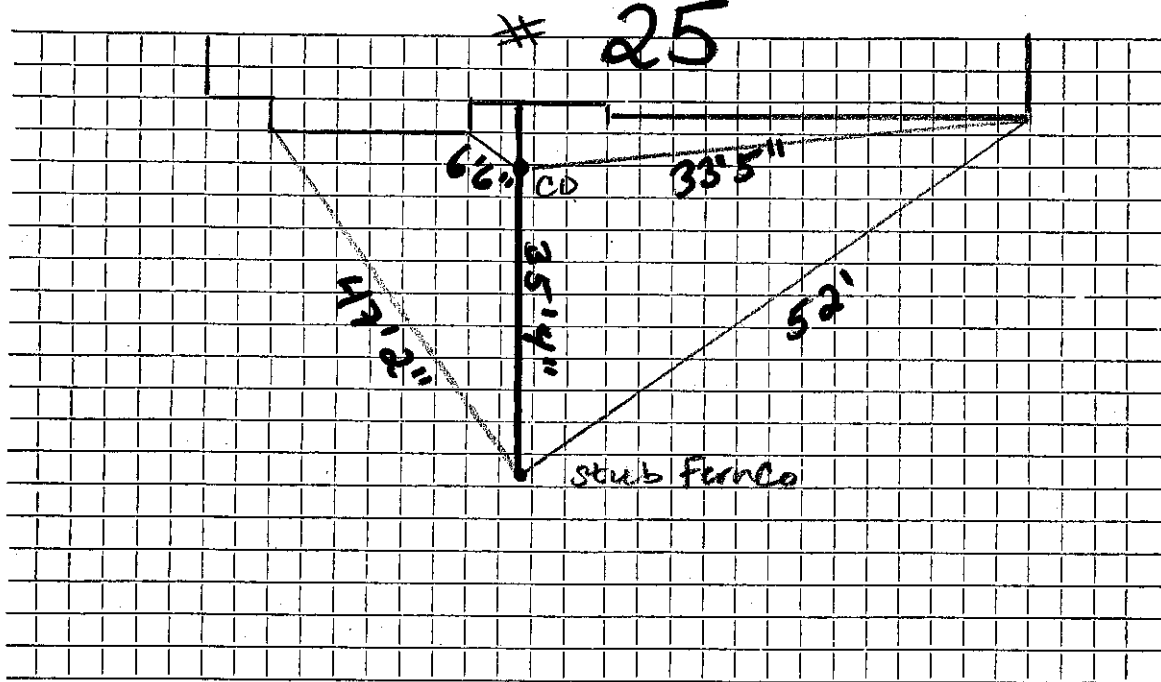

Connection made in Flintlock Street. Work completed .....

Remarks: .....